
T.8S. R.3W., W.M

MP 2 4 1999

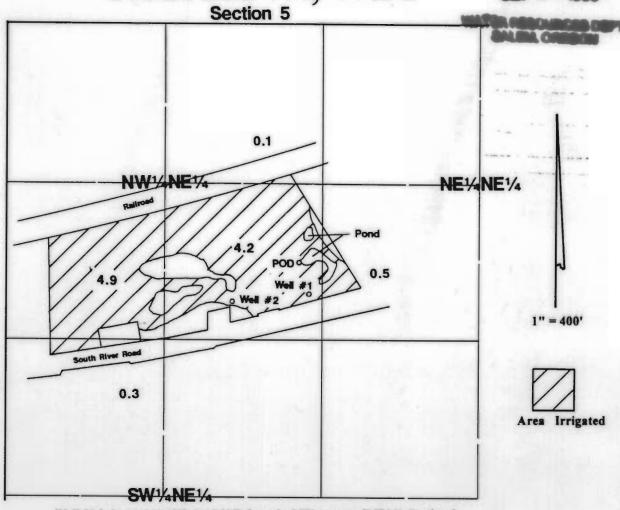

Well #1 is located 1140'S & 1260'E from the NW corner of NE1/4, Section 5. Well #2 is located 1170'S & 950'E from the NW corner of NE1/4 Section 5. POD is located 980'S & 1245'E from the NW corner of NE1/4 Section 5.

Final Proof Survey

Application #: R-721104 **Permit #:** R-11543 G-12744 G-12211

In Name Of

Gary G. Benson

Surveyed on September 10, 1999 by JM Schuette

This Map Was Prepared For The Purpose Of Identifying The Location Of A Water Right Only And Is Not Intended To Provide Legal Dimensions Or Location Of Property Ownership Lines.

