
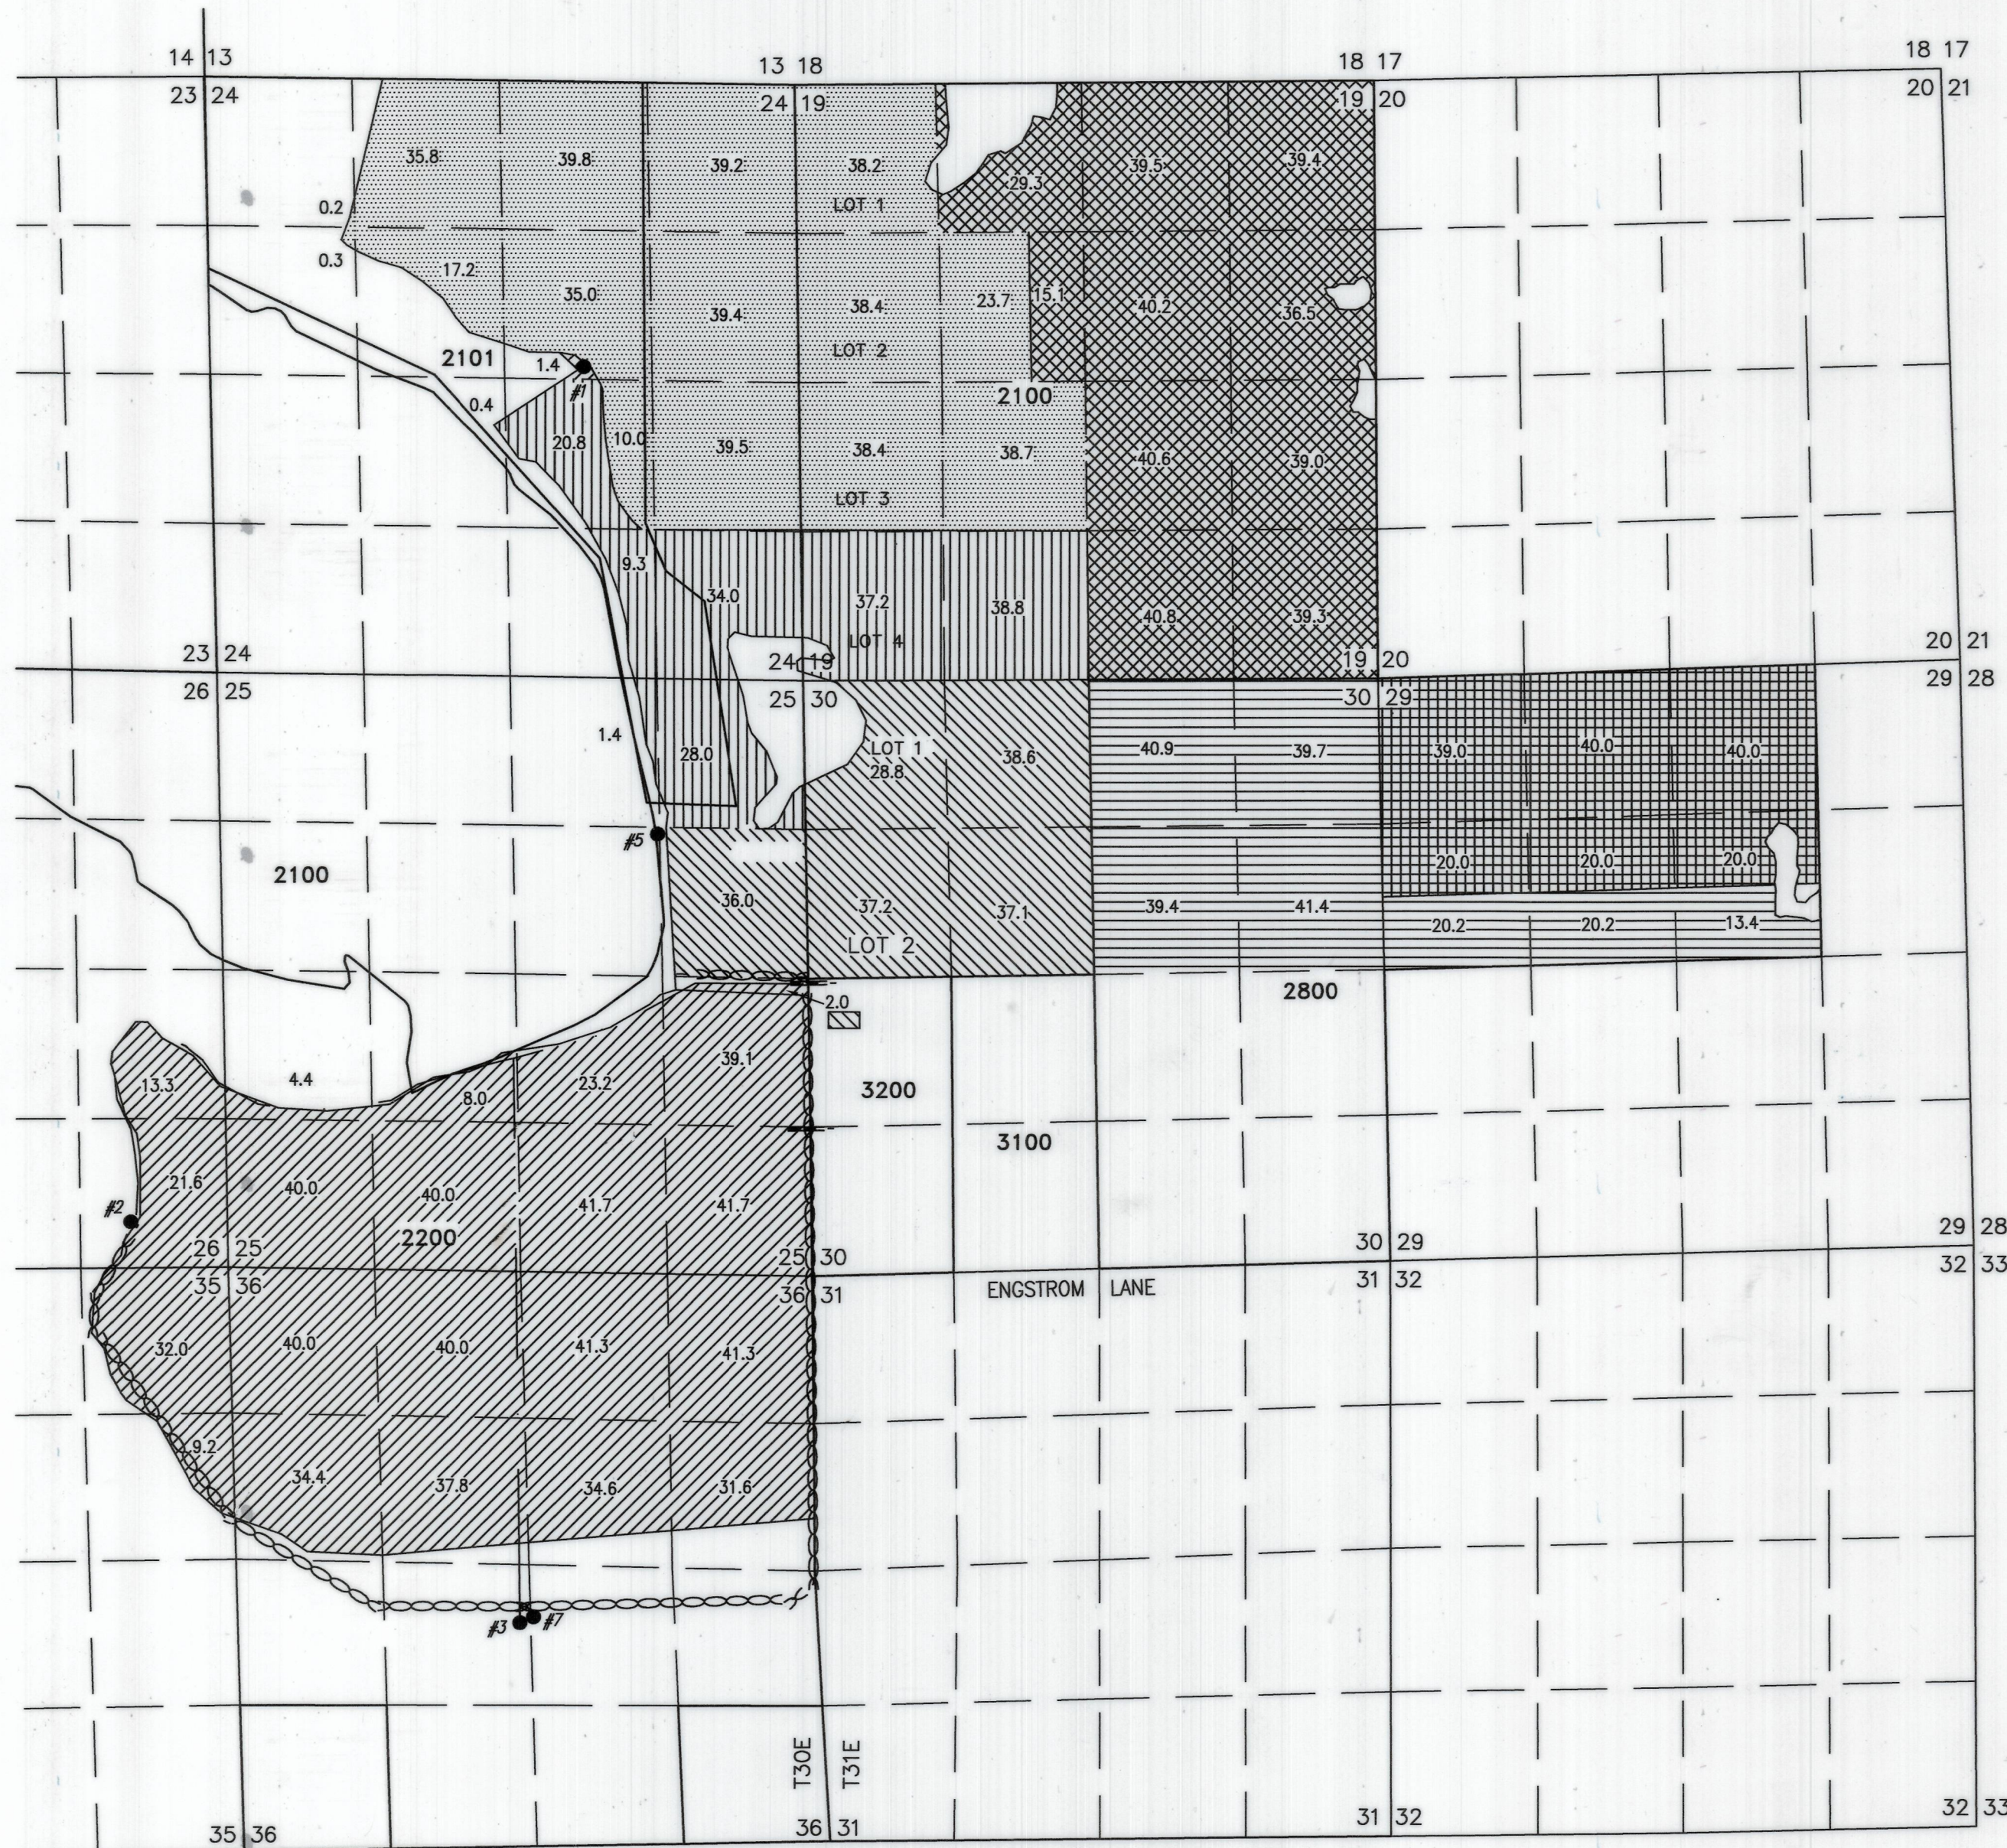
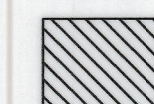
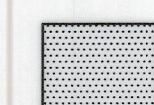
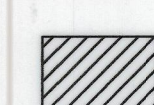
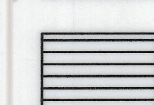
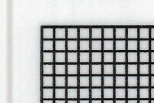


CLAIM OF BENEFICIAL USE MAP

TO ADD POINTS OF APPROPRIATION
PER APPLICATION T-11751
FOR MIKE PEILA

TOWNSHIP 24 SOUTH, RANGE 30 & 31 EAST, W.M.
TAX LOTS: 2100, 2101, 2200, & 3200
HARNEY COUNTY, OREGON

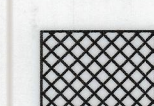


-  WELLS 2, 3, 5, & 7 TO EXISTING 171.3 ACRES PRIMARY IRRIGATION FROM WELL 1 OF PERMIT G-1643, AS SHOWN.
-  WELLS 3, 5, & 7 TO EXISTING 179.7 ACRES PRIMARY IRRIGATION FROM WELLS 1 & 2 OF PERMIT G-1643, AS SHOWN
-  WELLS 2, 3, 5, & 7 TO EXISTING 433.8 ACRES SUPPLEMENTAL IRRIGATION FROM WELL 1 OF PERMIT G-1643, AS SHOWN. PRIMARY IRRIGATION FROM SILVIE'S RIVER DECREE, V. 9, P. 79.
-  WELLS 1, 3, 5, & 7 TO EXISTING 615.2 ACRES PRIMARY IRRIGATION FROM WELL 2 OF PERMIT G-1643, AS SHOWN
-  WELLS 3, 5 & 7 TO EXISTING 215.2 ACRES PRIMARY IRRIGATION FROM WELLS 1 & 2 OF PERMIT G-5073, AS SHOWN
-  WELLS 3, 5, & 7 TO EXISTING 179.0 ACRES SUPPLEMENTAL IRRIGATION FROM WELLS 1 & 2 OF PERMIT G-5073, AS SHOWN. PRIMARY IRRIGATION FROM SILVIE'S RIVER DECREE, V. 9, P. 79.
-  WELLS 2, 3, 5, & 7 TO EXISTING 359.7 ACRES SUPPLEMENTAL IRRIGATION FROM WELL 1 OF PERMIT G-5073, AS SHOWN. PRIMARY IRRIGATION FROM SILVIE'S RIVER DECREE, V. 9, P. 79.

- POA #1 (HARN 841/2)
LOCATED IN THE SW 1/4 OF THE NE 1/4 OF SECTION 24, T24S, R30E, W.M. AND 2450' S & 630' W FROM THE E 1/16 CORNER BETWEEN SECTIONS 13 & 24.
FLOWMETER IS LOCATED ON THE DELIVERY PIPE 8 FEET WEST FROM THE WELL.
- POA #2 (HARN 844)
LOCATED IN THE SE 1/4 OF THE SE 1/4 OF SECTION 26, T24S, R30E, W.M. AND 2270' S & 6160' W FROM THE E 1/4 CORNER SECTION 25.
FLOWMETER IS LOCATED ON THE DELIVERY PIPE 11 FEET SE FROM THE WELL
- POA #3 (HARN 51332)
LOCATED IN THE NE 1/4 OF THE SW 1/4 OF SECTION 36, T24S, R30E, W.M. AND 1835' N & 2625' E FROM THE SW CORNER SECTION 36.
FLOWMETER IS LOCATED ON THE DELIVERY PIPE 5 FEET NW FROM THE WELL
- POA #5 (HARN 53133)
LOCATED IN THE SW 1/4 OF THE NE 1/4 OF SECTION 25, T24S, R30E, W.M. AND 1395' S & 1330' W FROM THE SE CORNER SECTION 25.
FLOWMETER IS LOCATED ON THE DELIVERY PIPE 2 FEET SOUTH FROM THE WELL
- POA #7 (HARN 52696)
LOCATED IN THE NE 1/4 OF THE SW 1/4 OF SECTION 36, T24S, R30E, W.M. AND 1845' N & 2785' E FROM THE SW CORNER SECTION 36.
FLOWMETER IS LOCATED ON THE DELIVERY PIPE 6 FEET EAST FROM THE WELL

RECEIVED RECEIVED
MAR 15 2024 MAR 04 2024
OWRD OWRD

— BURIED 6 OR 8 INCH STEEL PIPE —
— SURFACE SWALE OR DITCH —
— LEVEE OR DIKE —

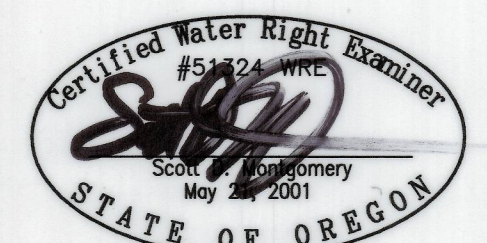

RENEWAL DATE: 12/31/2024

THIS MAP IS FOR THE PURPOSE OF LOCATING A WATER RIGHT ONLY AND HAS NO INTENT TO PROVIDE LEGAL DIMENSIONS OR THE LOCATION OF PROPERTY LINES

PREPARED FOR:

MIKE PEILA
P.O. BOX 537
HINES, OR 97738

PREPARED BY:



ALL POINTS ENGINEERING AND SURVEYING, INC.
P.O. BOX 767 TERREBONNE, OR 97760
(541) 548-5833 www.APEandS.com