


CLAIM OF BENEFICIAL USE AND SITE REPORT
IN THE NAME OF

WAYNE H. BREEZE
7159 Pine Ridge Drive
Medford, Or. 97504


Application No. R72096 and 72097

Permit No. R11474 and 51503

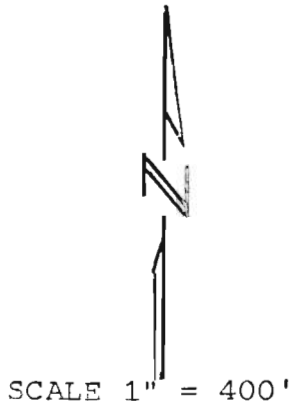

POND SITUATED 1106 ft.
NORTH AND 189.9 ft WEST
OF 1/4 COR TO SEC. 19
AND 20, T37S, R1E, WM.

CISTERN SITUATED 849.9
ft. NORTH AND 88.2 ft.
WEST OF 1/4 COR TO SEC.
19 AND 20, T37S, R1E, WM.

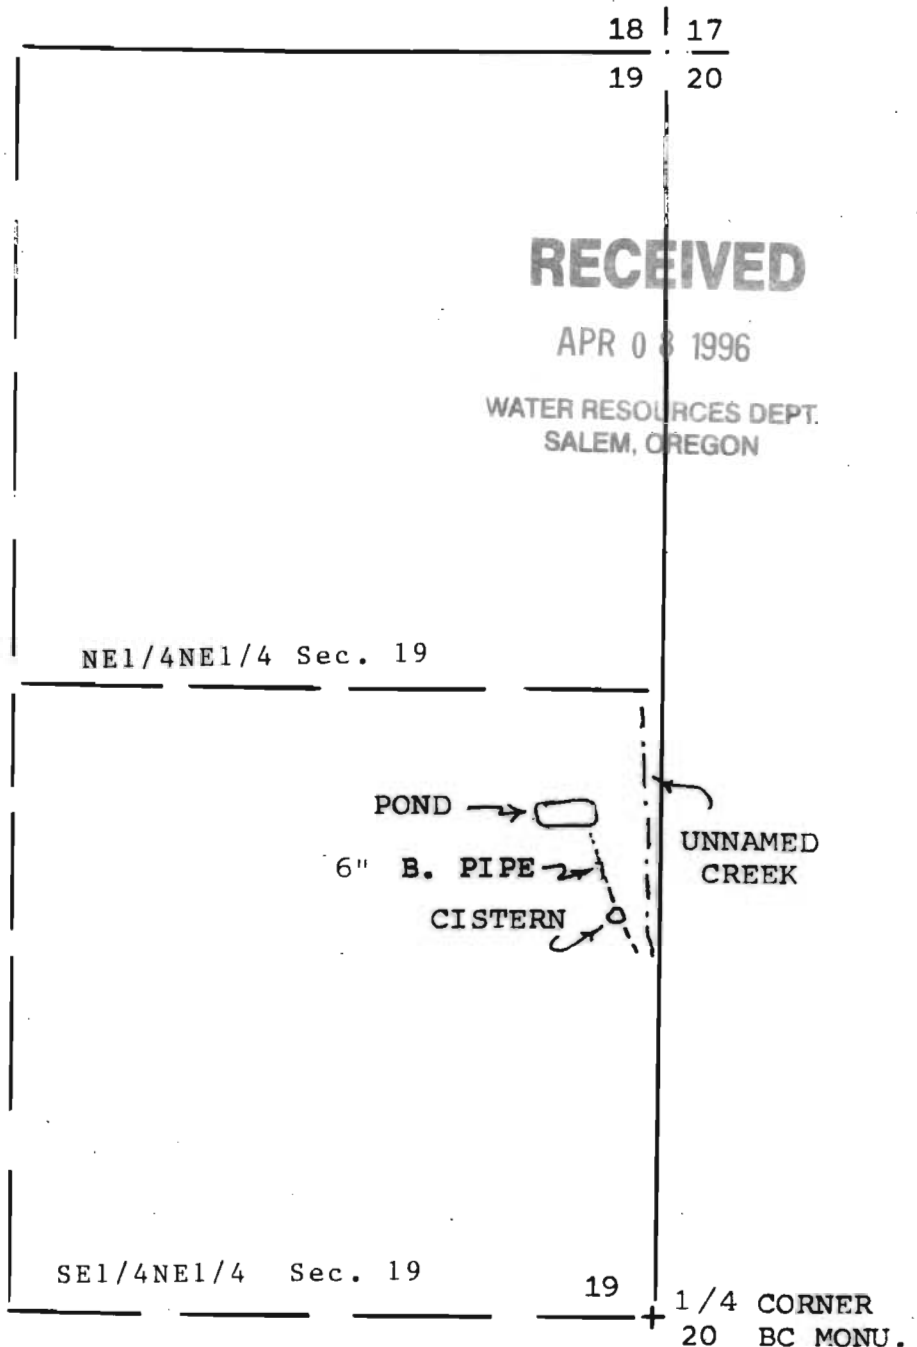

This map was prepared for the purpose of identifying the location of a water right only and is not intended to provide legal demensions or location of property ownership lines.