


FINAL PROOF SURVEY MAP

IN THE NAME OF LOWELL AND MARY MEYER

APPLICATION R-72118
S-72119

PERMIT R-11766
52136

SECTION 12, TOWNSHIP 29 SOUTH, RANGE 15 WEST, W.M.

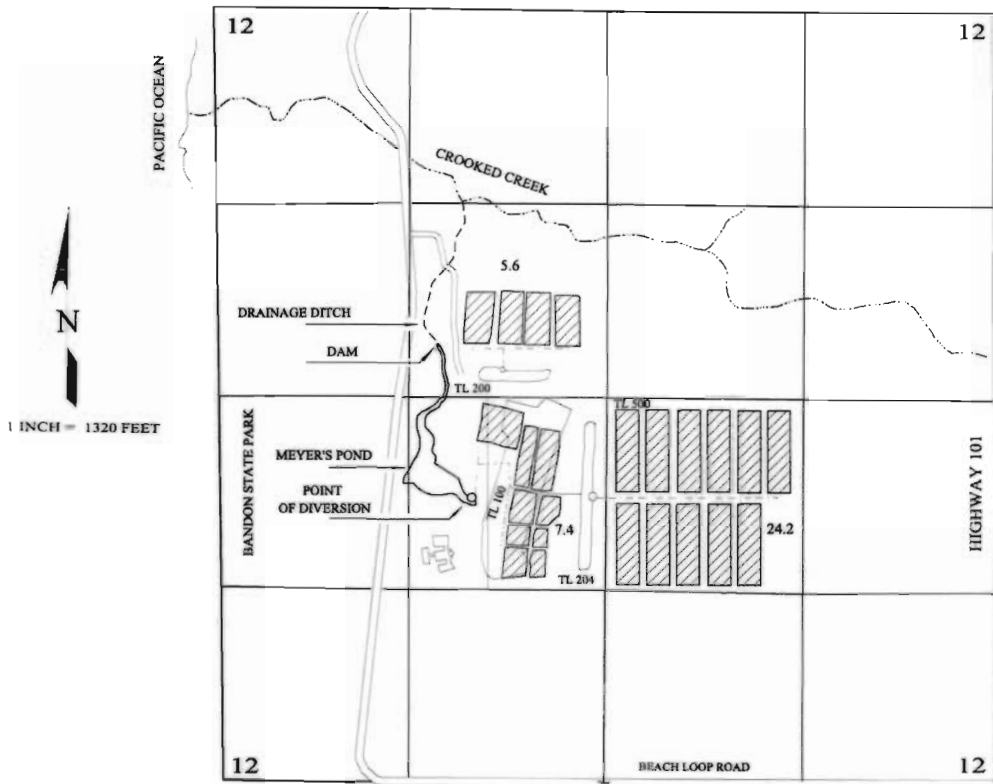

THE DAM IS LOCATED 3,030 FEET NORTH AND 1,130 FEET WEST AND THE PUMP POINT OF DIVERSION IS LOCATED 1,970 FEET NORTH AND 900 FEET WEST; BOTH FROM THE SOUTH QUARTER CORNER OF SECTION 12; BOTH WITHIN THE NE $\frac{1}{4}$ SW $\frac{1}{4}$ OF SECTION 12, TOWNSHIP 29 SOUTH, RANGE 15 WEST, W.M.; COOS COUNTY.

RECEIVED

OCT 11 2000

WATER RESOURCES DEPT.
SALEM, OREGON

THE PURPOSE OF THIS MAP IS TO IDENTIFY THE LOCATION OF THE WATER RIGHT. IT IS NOT INTENDED TO PROVIDE INFORMATION RELATIVE TO THE LOCATION OF PROPERTY OWNERSHIP BOUNDARY LINES.

