

T. 41 S. R. 8 W. W.M.

Sec.
3

17 Acres

39 1/2 Acres.

Ditch

Mc Briety

20 Acres

39 1/2 Acres.

Page Creek

20 Acres

24 Acres

House
Barn

20 Acres

22 Acres


I
V
E
R

Flume

Flume

D

17

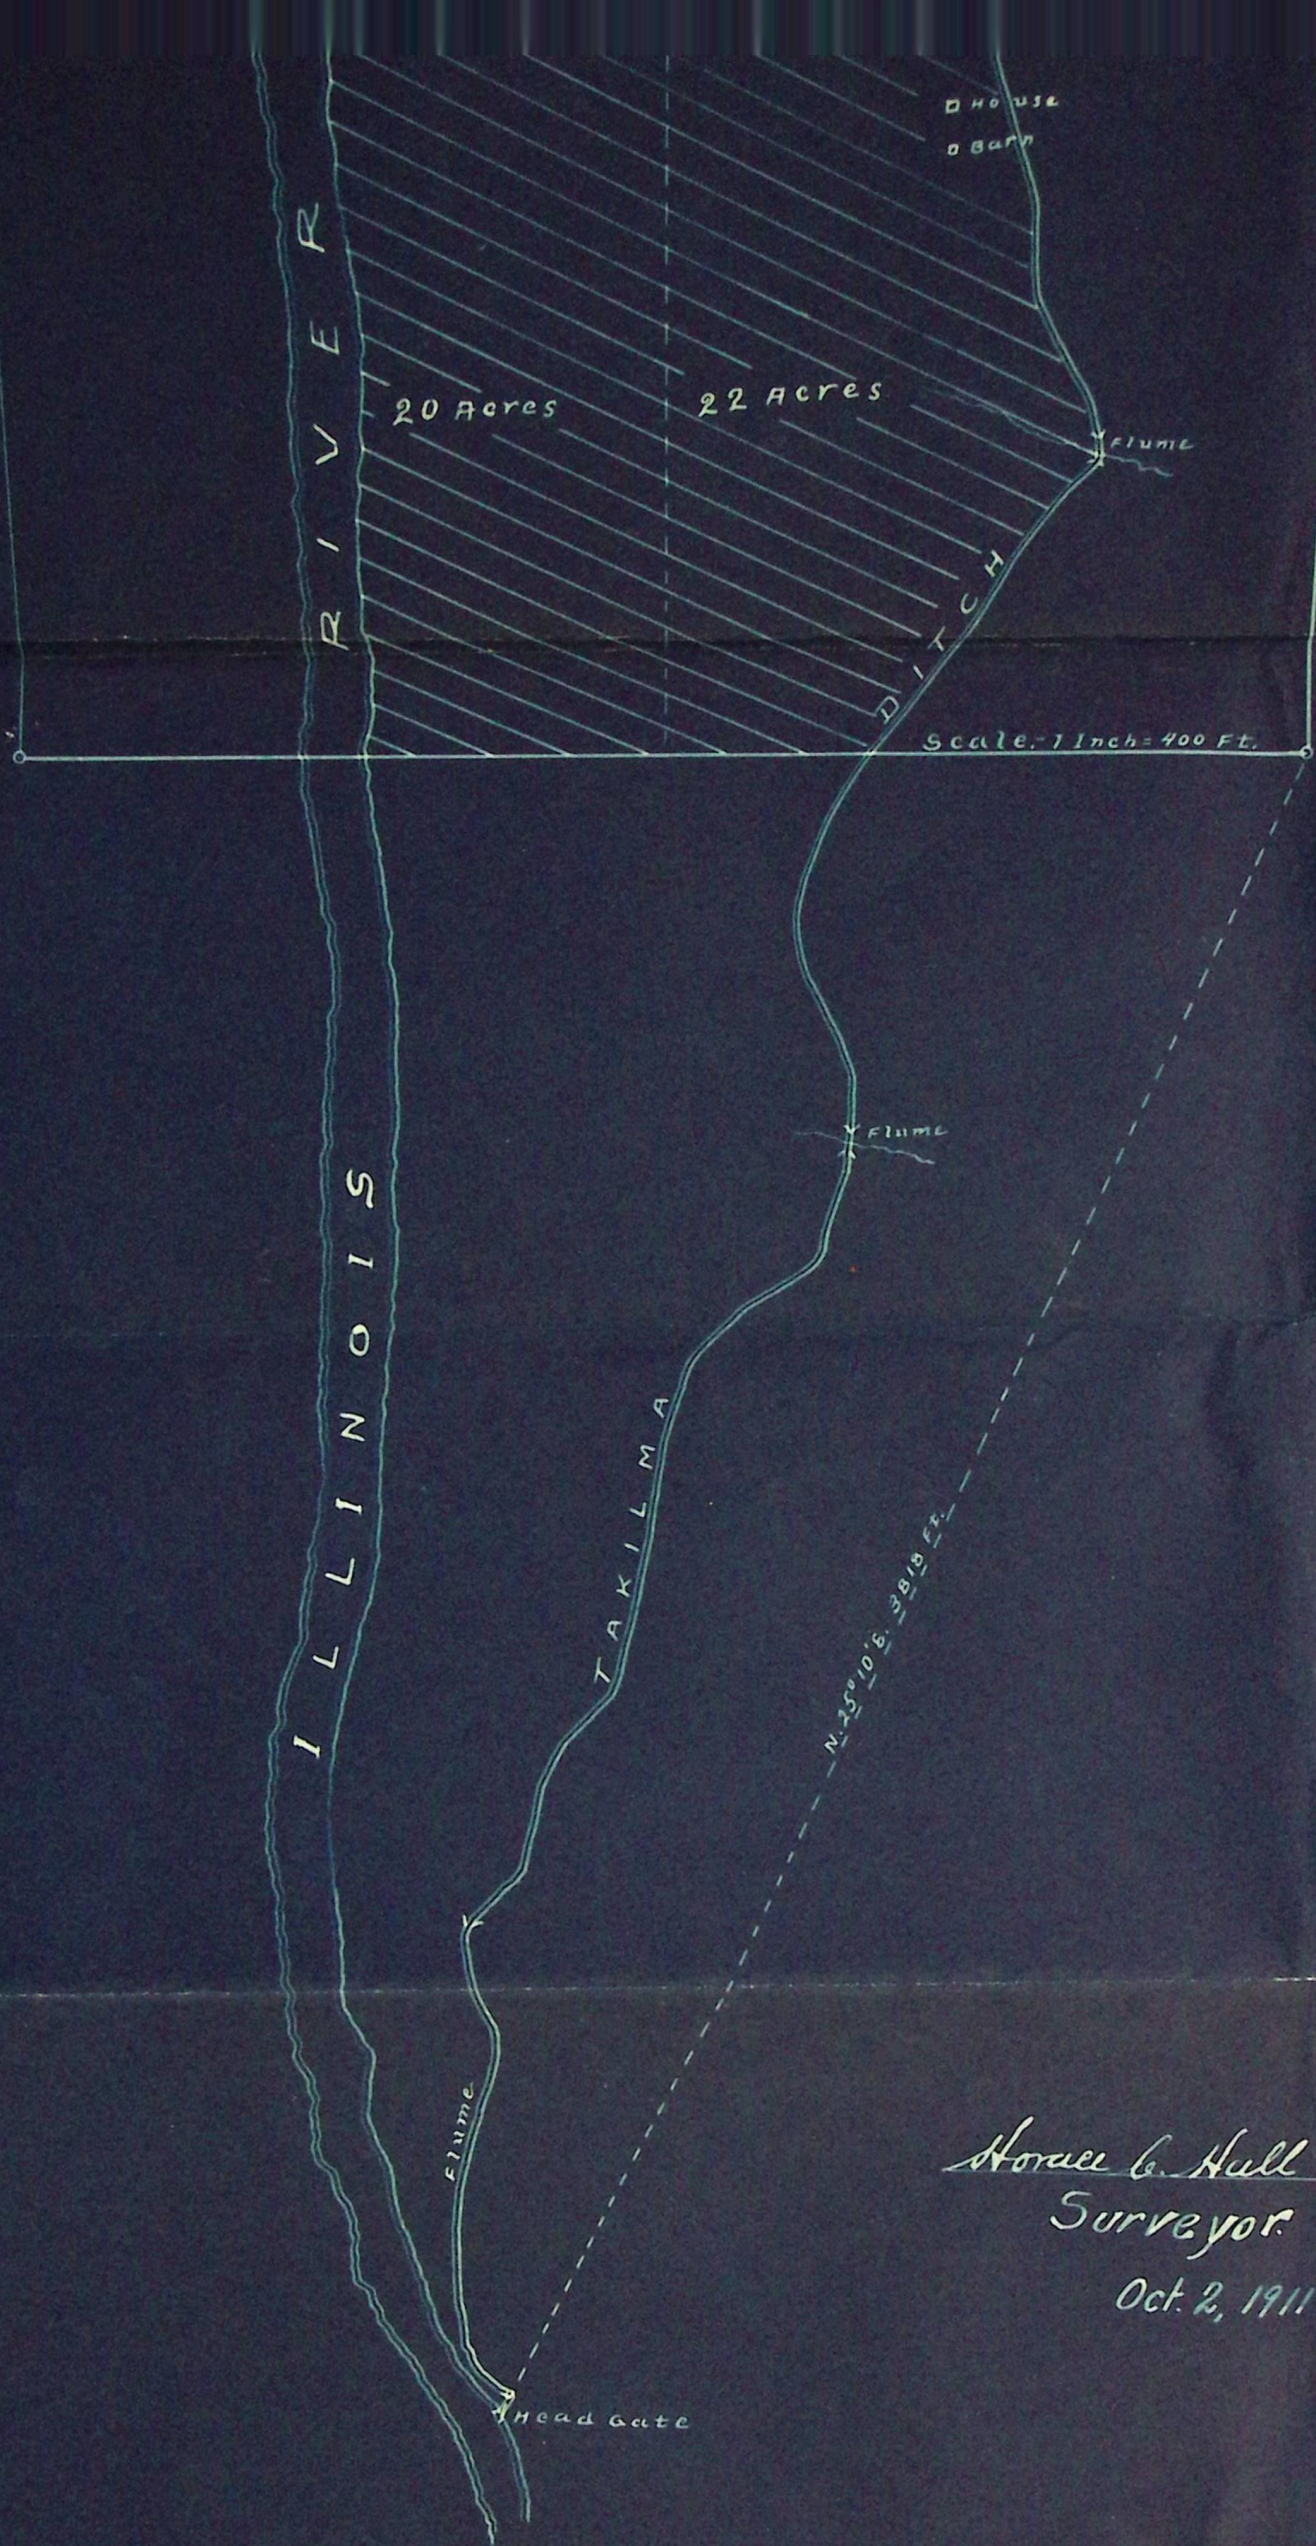

Horace C. Hull
 Surveyor.
 Oct. 2, 1911

MAP
OF THE
TAKILMA DITCH

The Waldo Smelting and Mining Co.
Claimants