


Township 5 North, Range 29 East, W.M.
 Umatilla County, Oregon
 Section 31

SCALE 1" = 200 Ft.


Well 1, UMAT 3784, Well ID L-154019, SW1/4 of NW1/4, Sec. 31
 Located 550' N & 375' E of W 1/4 Corner Section 31
 Lat. 45°52'23.472" N & Lon. 119°14'36.030" W
 Meter located in Small Well House with Well 1



N. OTT ROAD

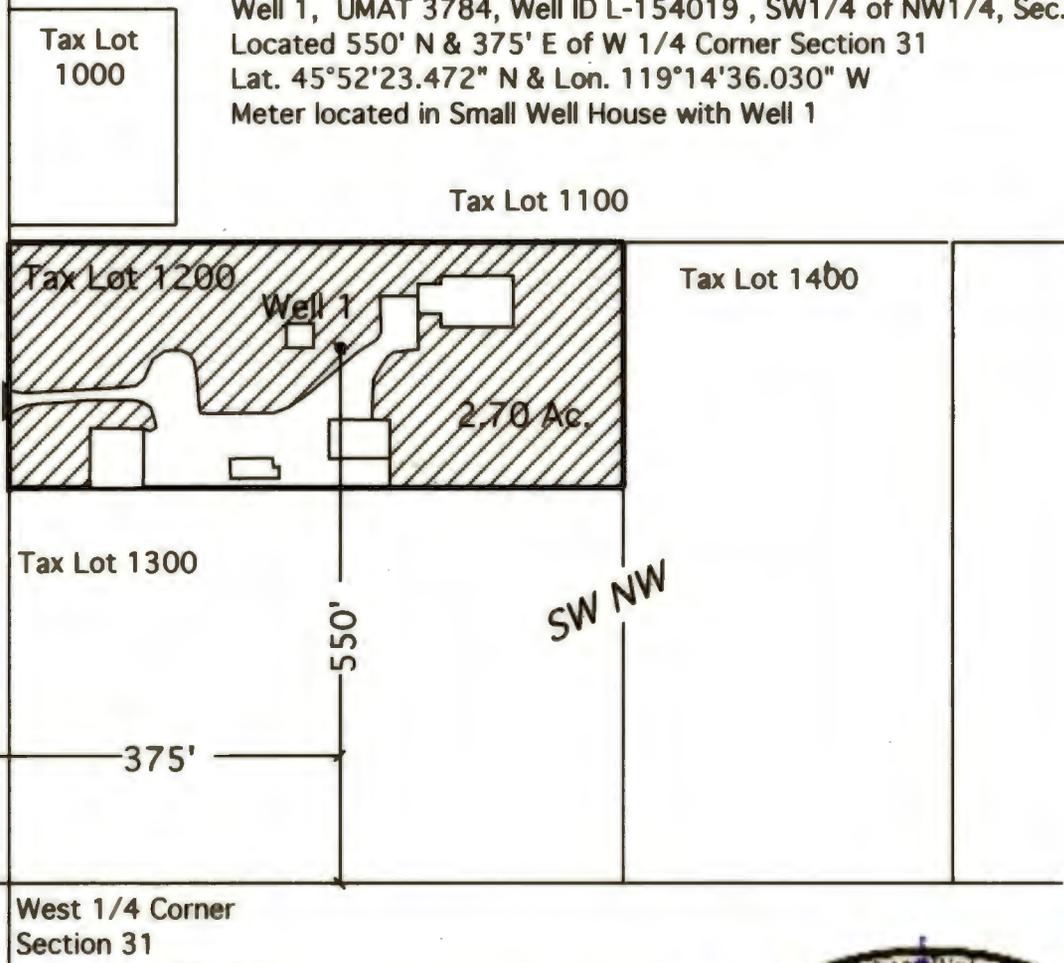

Irrigation for Permit G-16743
 Found @ This Location

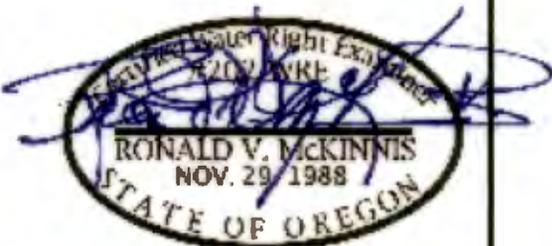

This Map is for the purpose of identifying the location of Water Rights only and is not intended to provide the legal dimensions or locations of property ownership lines.

FINAL PROOF MAP

In Name Of

CLYDE & EDIE LONGFELLOW

Expires 1-31-24

ENGINEERING - LAND SURVEYING - WATER RIGHTS

R. V. McKINNIS ENGINEERING

79980 Prindle Loop Road
 Hermiston, Oregon 97838
 (541) -567-2017




Received
 MAY 1 2024
 CIVIL