


T. 33 S., R. 5 W., W.M.

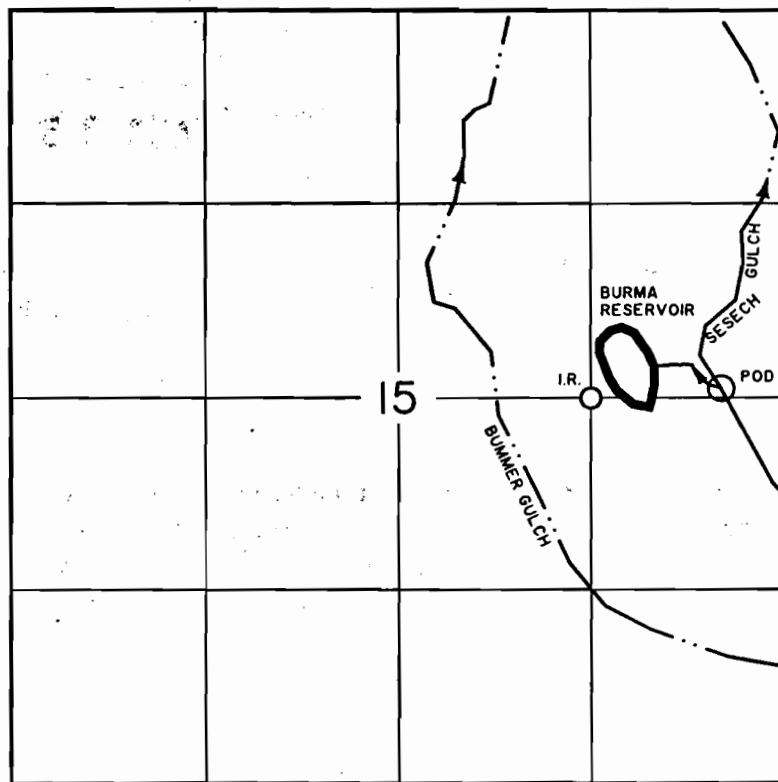

1" = 1320'



DIVERSION IS 62
FEET NORTH AND
888 FEET EAST OF
THE C-E 1/16 CORNER
OF SECTION 15.


CLAIM OF BENEFICIAL USE MAP

IN NAME OF

UNITED STATES BUREAU OF LAND MANAGEMENT

APPLICATION NO. S-72136
R-72135

PERMIT NO. 51906
R-11790

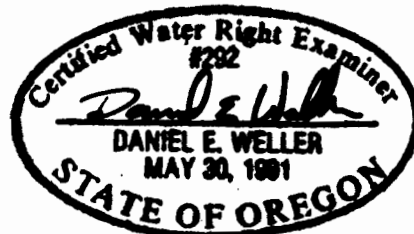

SURVEYED: JUNE 8, 1999

EXPIRES 6/30/00

THE PURPOSE OF THIS MAP IS FOR IDENTIFYING THE LOCATION OF THE WATER RIGHT ONLY AND
IS NOT INTENDED TO PROVIDE LEGAL DIMENSIONS OR LOCATION OF PROPERTY OWNERSHIP LINES.

U.S. BUREAU OF LAND MANAGEMENT-OSO
BRANCH OF GEOGRAPHIC SCIENCES

DWG: BURMA

EXECUTED BY:
DANIEL E. WELLER, PLS, CWRE
P.O. BOX 2965
PORTLAND, OREGON 97208