


T. 33 S., R. 5 W., W.M.

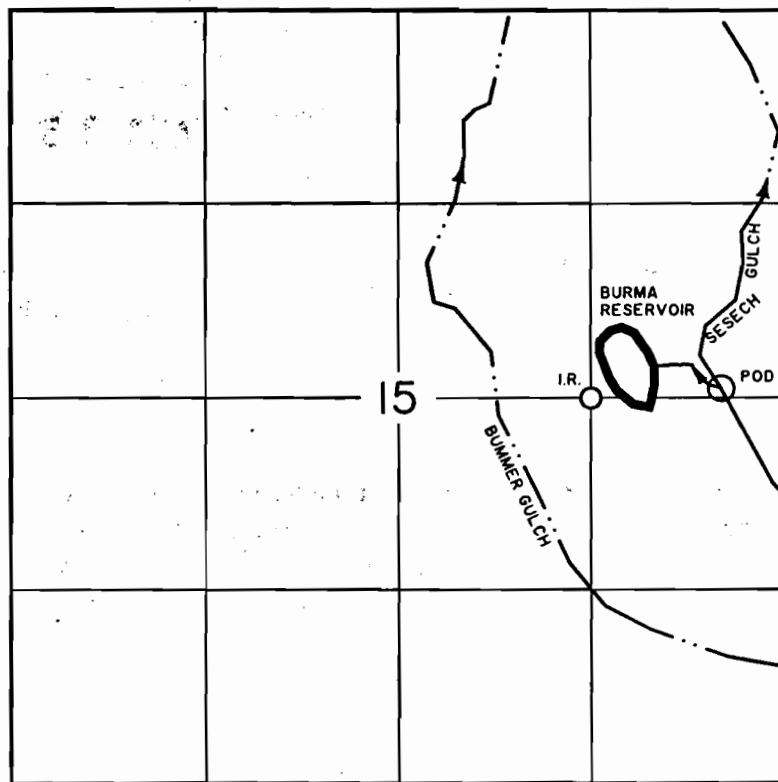

1" = 1320'



DIVERSION IS 62
FEET NORTH AND
888 FEET EAST OF
THE C-E 1/16 CORNER
OF SECTION 15.


CLAIM OF BENEFICIAL USE MAP

IN NAME OF

UNITED STATES BUREAU OF LAND MANAGEMENT

APPLICATION NO. S-72136
R-72135

PERMIT NO. 51906
R-11790

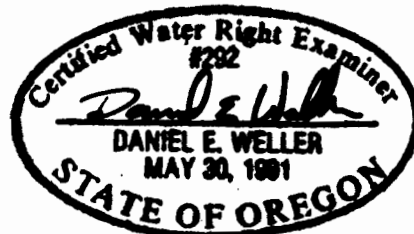

EXPIRES 6/30/00

SURVEYED: JUNE 8, 1999

THE PURPOSE OF THIS MAP IS FOR IDENTIFYING THE LOCATION OF THE WATER RIGHT ONLY AND
IS NOT INTENDED TO PROVIDE LEGAL DIMENSIONS OR LOCATION OF PROPERTY OWNERSHIP LINES.

U.S. BUREAU OF LAND MANAGEMENT-OSO
BRANCH OF GEOGRAPHIC SCIENCES

DWG: BURMA

EXECUTED BY:
DANIEL E. WELLER, PLS, CWRE
P.O. BOX 2965
PORTLAND, OREGON 97208

U.S. DEPARTMENT OF INTERIOR
BUREAU OF LAND MANAGEMENT
MEDFORD DISTRICT

MAP TO ACCOMPANY APPLICATION FOR WATER USE PERMIT
SHOWING DIVERSION POINT LOCATION

SECTION 15, TOWNSHIP 33 South, RANGE 5 West, W.M.
REFERENCE: N/A CO. ASSESSORS MAP NO. N/A

RECEIVED

FEB 28 1982

WATER RESOURCES DEPT.
SALEM, OREGON

BURMA
Res.

U.S.

ditch

Diversion Point
SECESH CK.

PVT.

THIS MAP IS FOR THE PURPOSE OF IDENTIFYING THE
LOCATION OF THE WATER RIGHT ONLY AND IS NOT
INTENDED TO PROVIDE LEGAL DIMENSIONS OR LOCATIONS
OF PROPERTY OWNERSHIP LINES.

DIVERSION LOCATION: Reservoir is situated in
SE1/4NE1/4, SW1/4NE1/4, NE1/4SE1/4 Section 15

Diversion point is 62.04 feet North and
888.45 feet East of the Centereast 1/16
corner Section 15.

OWNERSHIP: U.S.D.I. Bureau of Land Management
3040 Biddle Rd.
Medford, Or. 97504



Application No. R-72135
Permit No. R11790