


T. 38 S., R. 1 W., W.M.

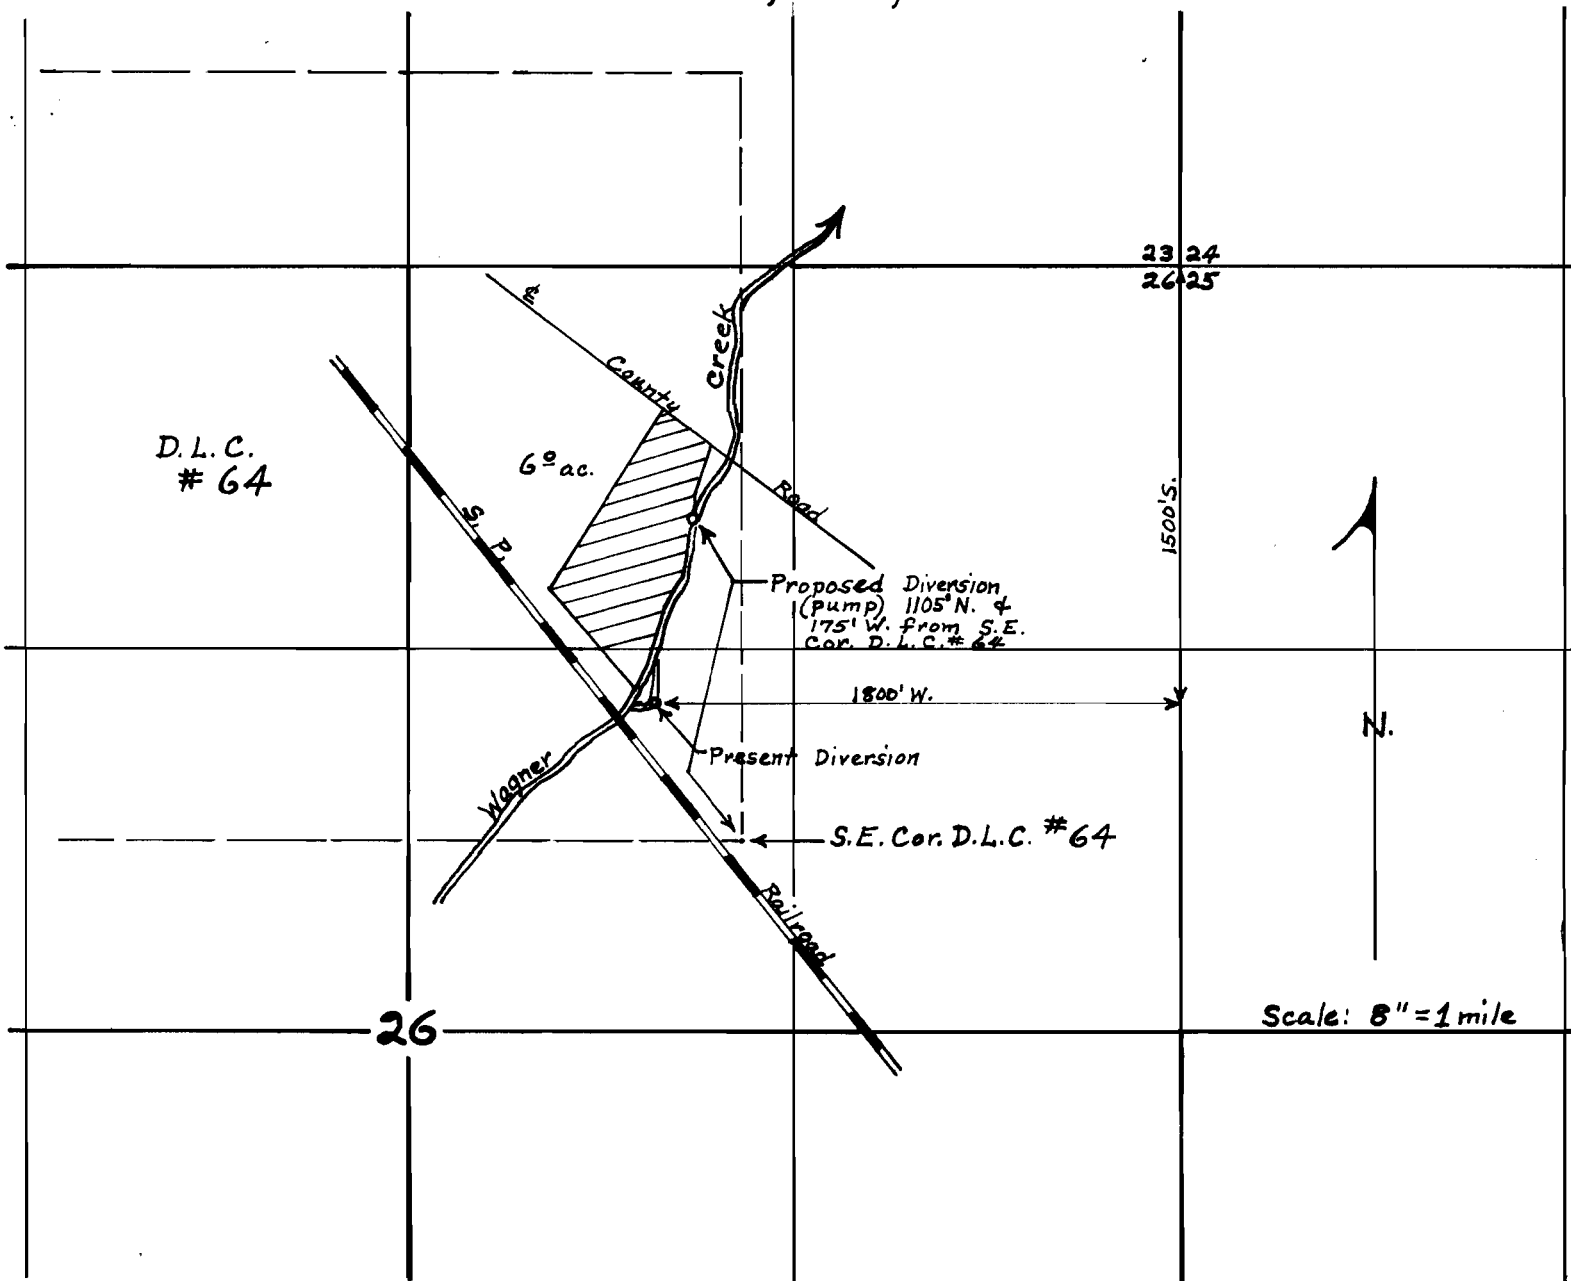

J. S. Caudill - Change in Point of Diversion

10 13-64

D. L. Hendrix, Watermaster Dist. #13