


# Section 12, T.7S., R.4W., W.M.

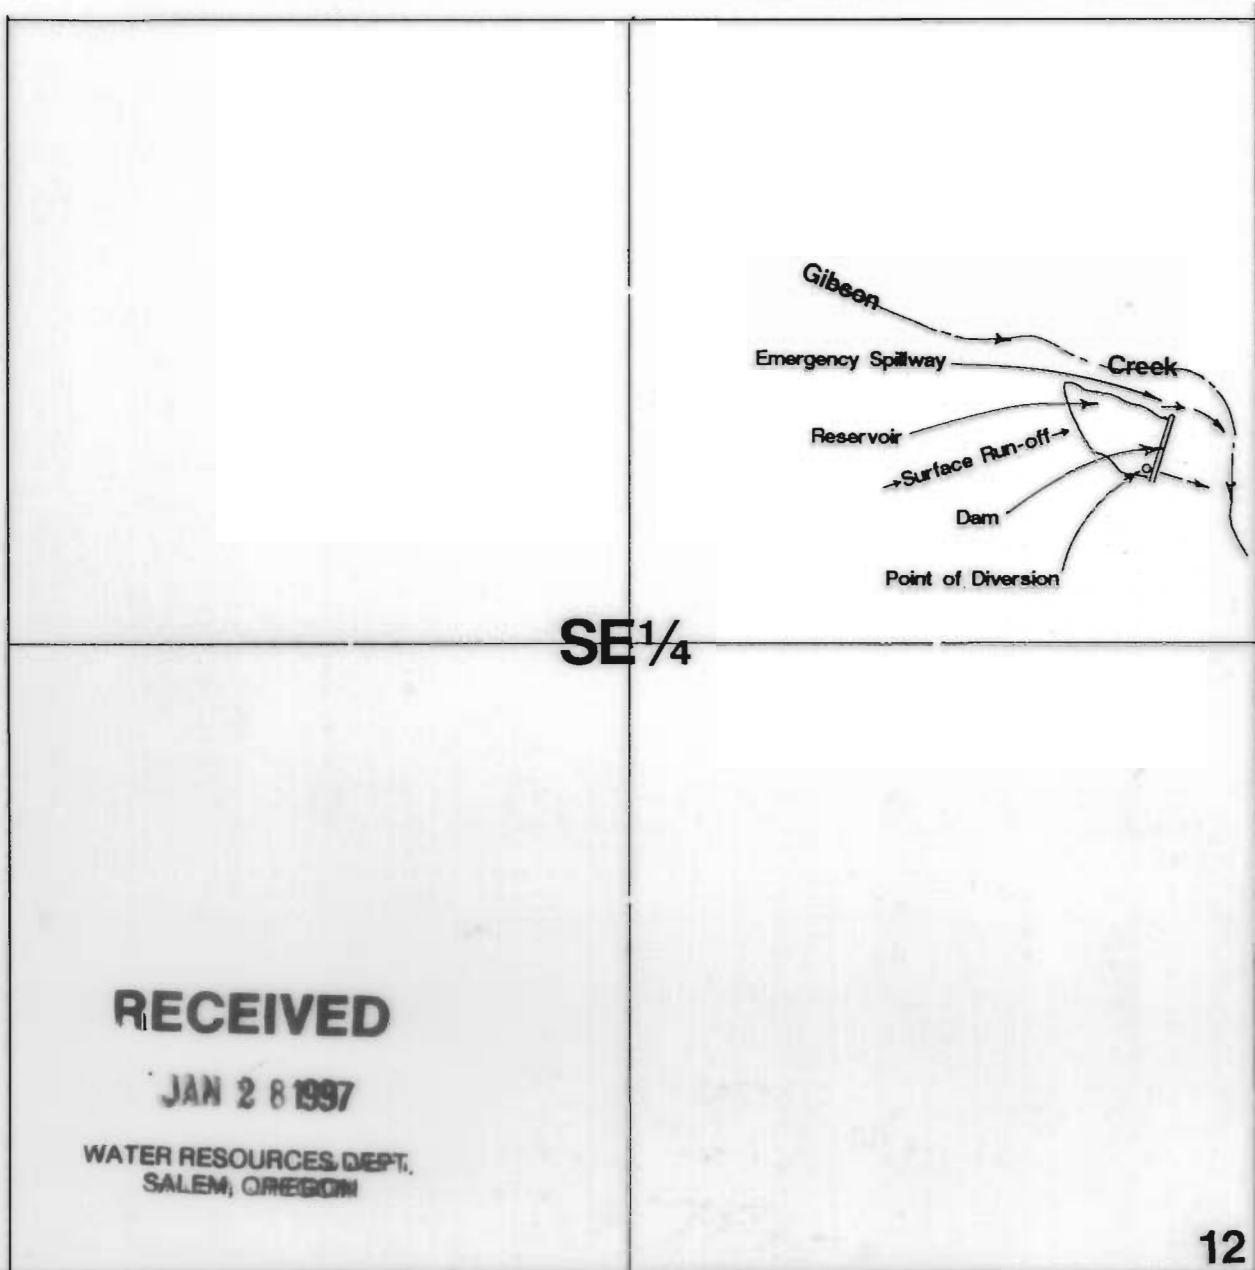

SE 1/4

1" = 400'

**RECEIVED**

JAN 28 1997

WATER RESOURCES DEPT.  
SALEM, OREGON

12 7  
13 9

Point of Diversion located 1685'N & 235'W from SE corner Section 12.

## Final Proof Survey

Application #: R-72216    Permit #: R-11520

In Name Of

### Douglas Stoller

Surveyed on January 18, 1997 by JM Schuette

THIS MAP WAS PREPARED FOR THE PURPOSE OF IDENTIFYING THE LOCATION OF A WATER RIGHT ONLY AND IS NOT INTENDED TO PROVIDE LEGAL DIMENSIONS OR LOCATION OF PROPERTY OWNERSHIP LINES.

