
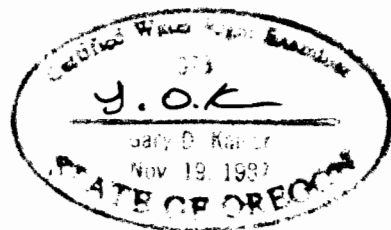
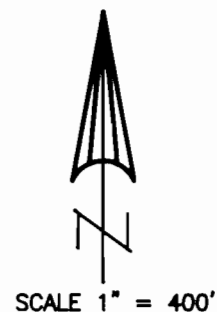


T.35S.,R.2W.,W.M.

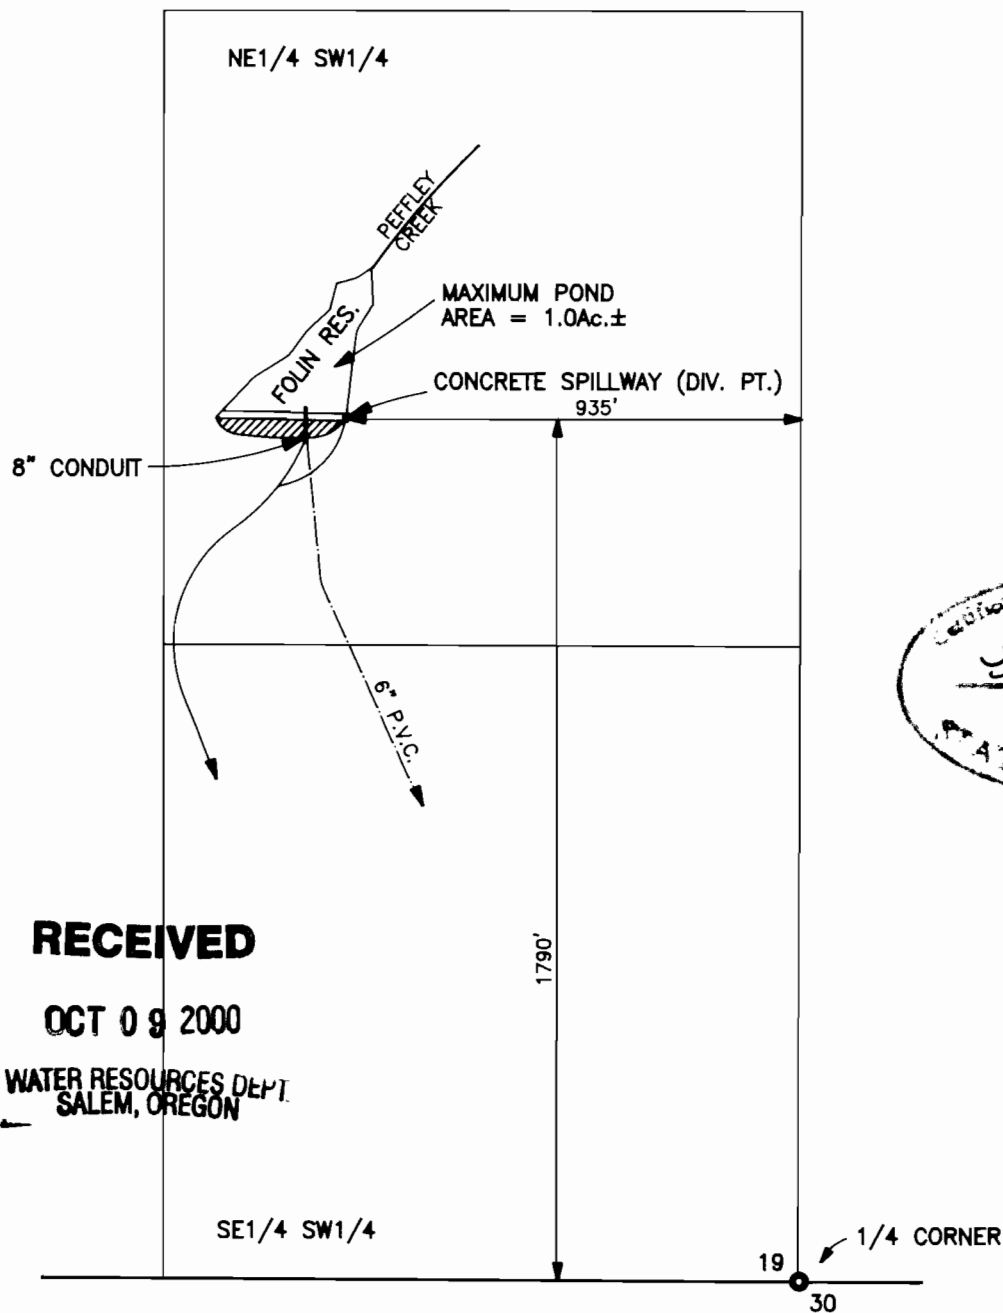

RECEIVED

OCT 09 2000

**WATER RESOURCES DEPT.
SALEM, OREGON**

FINAL PROOF MAP

APPLICATION No. R-72230
PERMIT No. R-11947

IN THE NAME OF
SCOTT C. FOLIN

NOTE: MAP PREPARED FOR
WATER RIGHT PURPOSES ONLY,
NOT FOR PROPERTY BOUNDARY
LOCATIONS.

MAP PREPARED MAY 17, 2000 BY GARY D. KAISER