


Document Path: Y:\175\_Erin\_Donahue\Source\_Figures\001\_WF\COBU\_S883359\_S55028.mxd iramos

**LEGEND**

- Point of Re-Diversion
- Fish Screen
- Meter
- Conveyance Line (portable)
- Place of Use (POU)
- Tax Lot
- Government Lot (GL)
- Major Road
- Watercourse
- Waterbody

**Claim of Beneficial Use Map  
in the name of Christine Donahue**  
Application S-88259 Permit S-55028  
Township 15 South, Range 4 West (W.M.)

**CERTIFIED WATER RIGHTS EXAMINER STAMP**

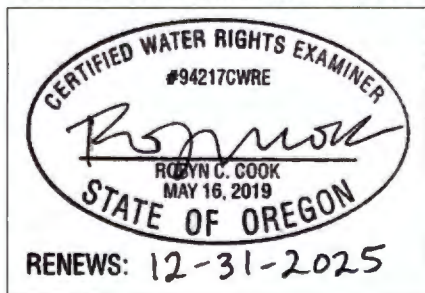

Received  
APR 04 2024  
OWRD

**LOCATION DESCRIPTION**  
POD 1  
Located 1,670 feet South and 1,290 feet West from the NE corner of Section 14, Township 16 South, Range 4 West (W.M.)

**DISCLAIMER**  
This map was prepared for the purpose of identifying the location of a water right only and it is not intended to provide legal dimensions or location of property ownership lines.

Date: March 8, 2024  
Data Sources: BLM, ESRI, OWRD, USGS

