

FINAL PROOF MAP

RECEIVED

Under

Application No. R-72238, Permit No. R-11483

MAR - 4 1996

And Application No. 72239, Permit No. 51519

WATER RESOURCES DEPT.

In the Name of: Sid Johnson SALEM, OREGON


3150 10th Street

Baker City, OR 97814


Scale 1" = 400'

T10S R41E

C1/4

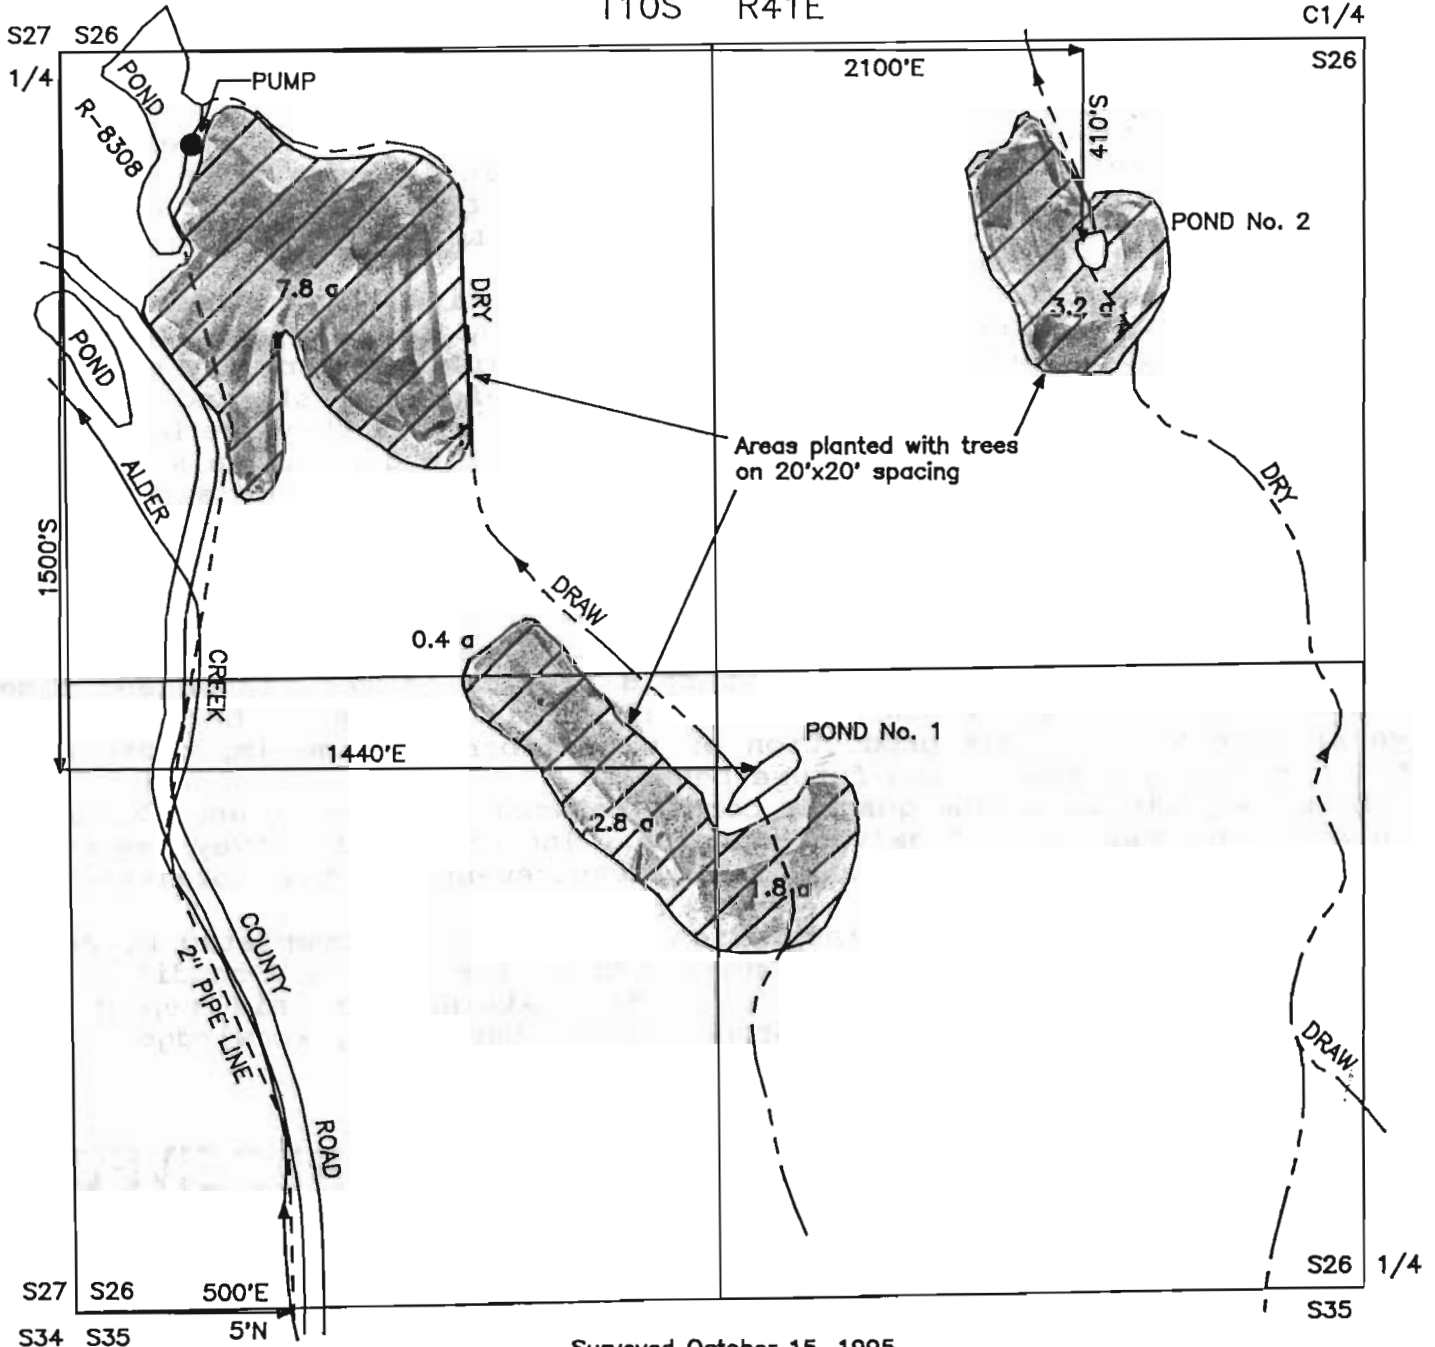

Surveyed October 15, 1995

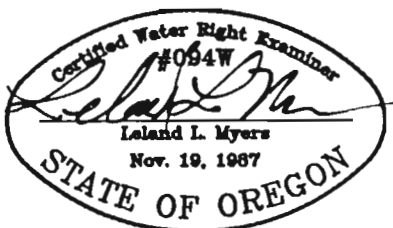

This map is for the purpose of identifying the location of the water right only and has no intent to provide dimensions or location of property ownership lines.