



# Claim of Beneficial Use - Abrams

## Application G-16643, Permit G-16428

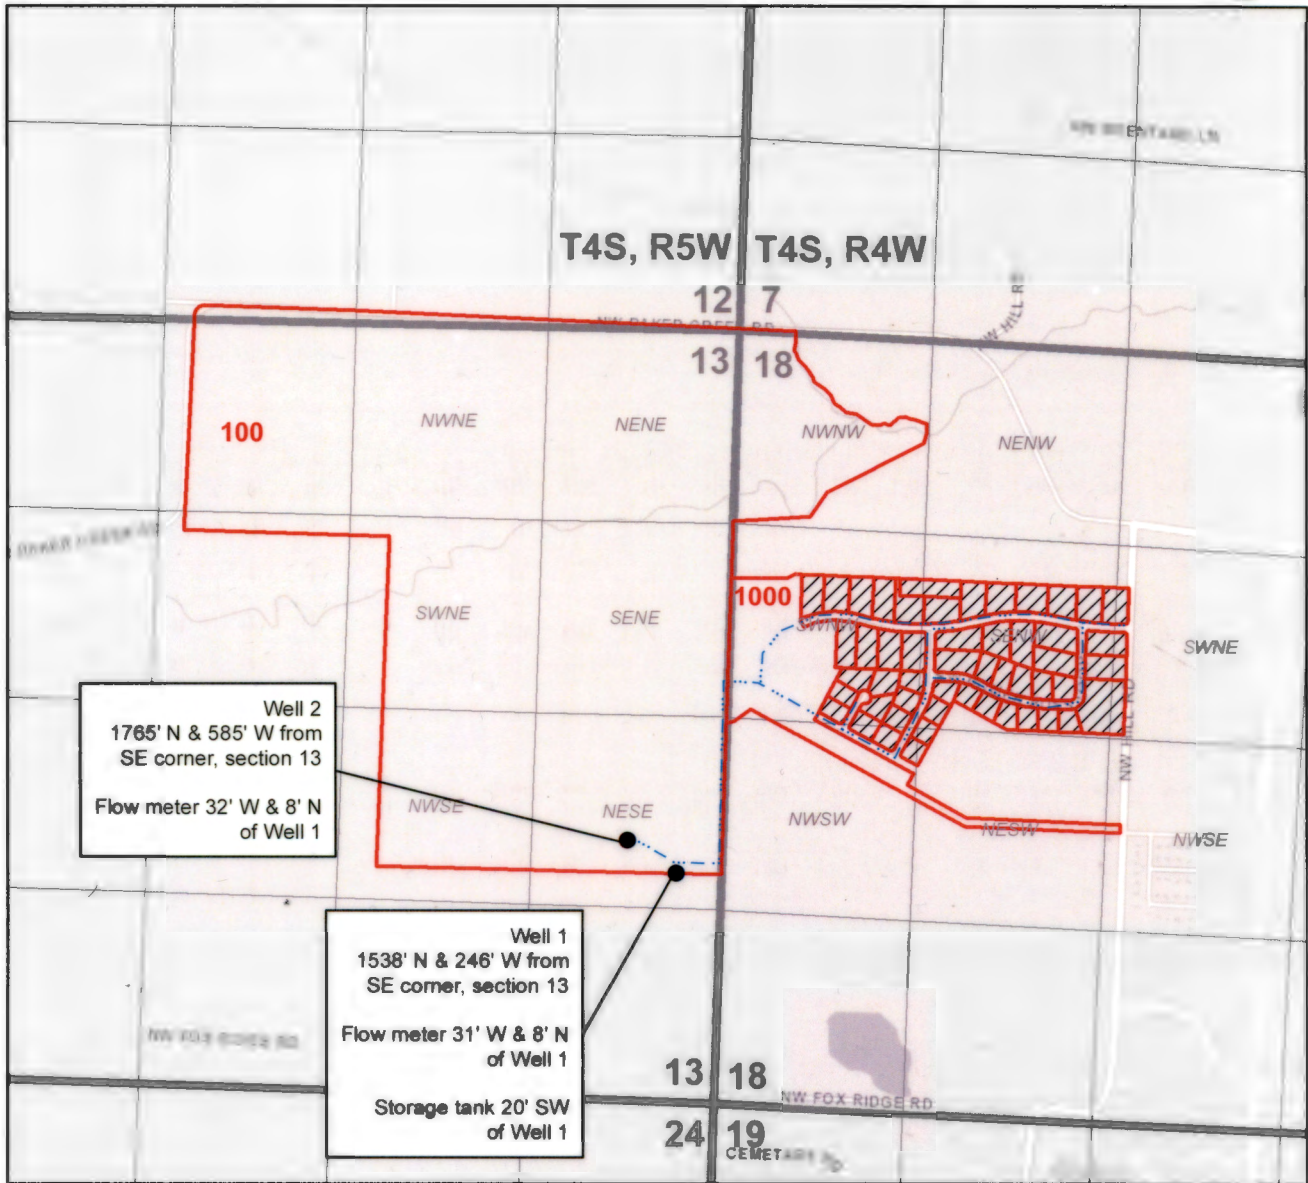

This map is not intended to provide legal dimensions or locations of property ownership lines.

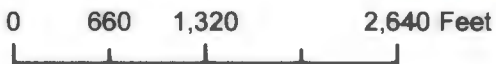

### Legend

- POU
- Mainline
- Taxlots\*

\*see assessor's map for other TL nos.

