


THIS MAP WAS PREPARED FOR
ASSESSMENT PURPOSE ONLY

0 200 400 600 800 Feet


SECTION 3 T.8S. R.46E. W.M.
BAKER COUNTY
1" = 400'

08S46E03

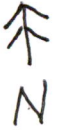

Received
APR 15 2024

OWRD

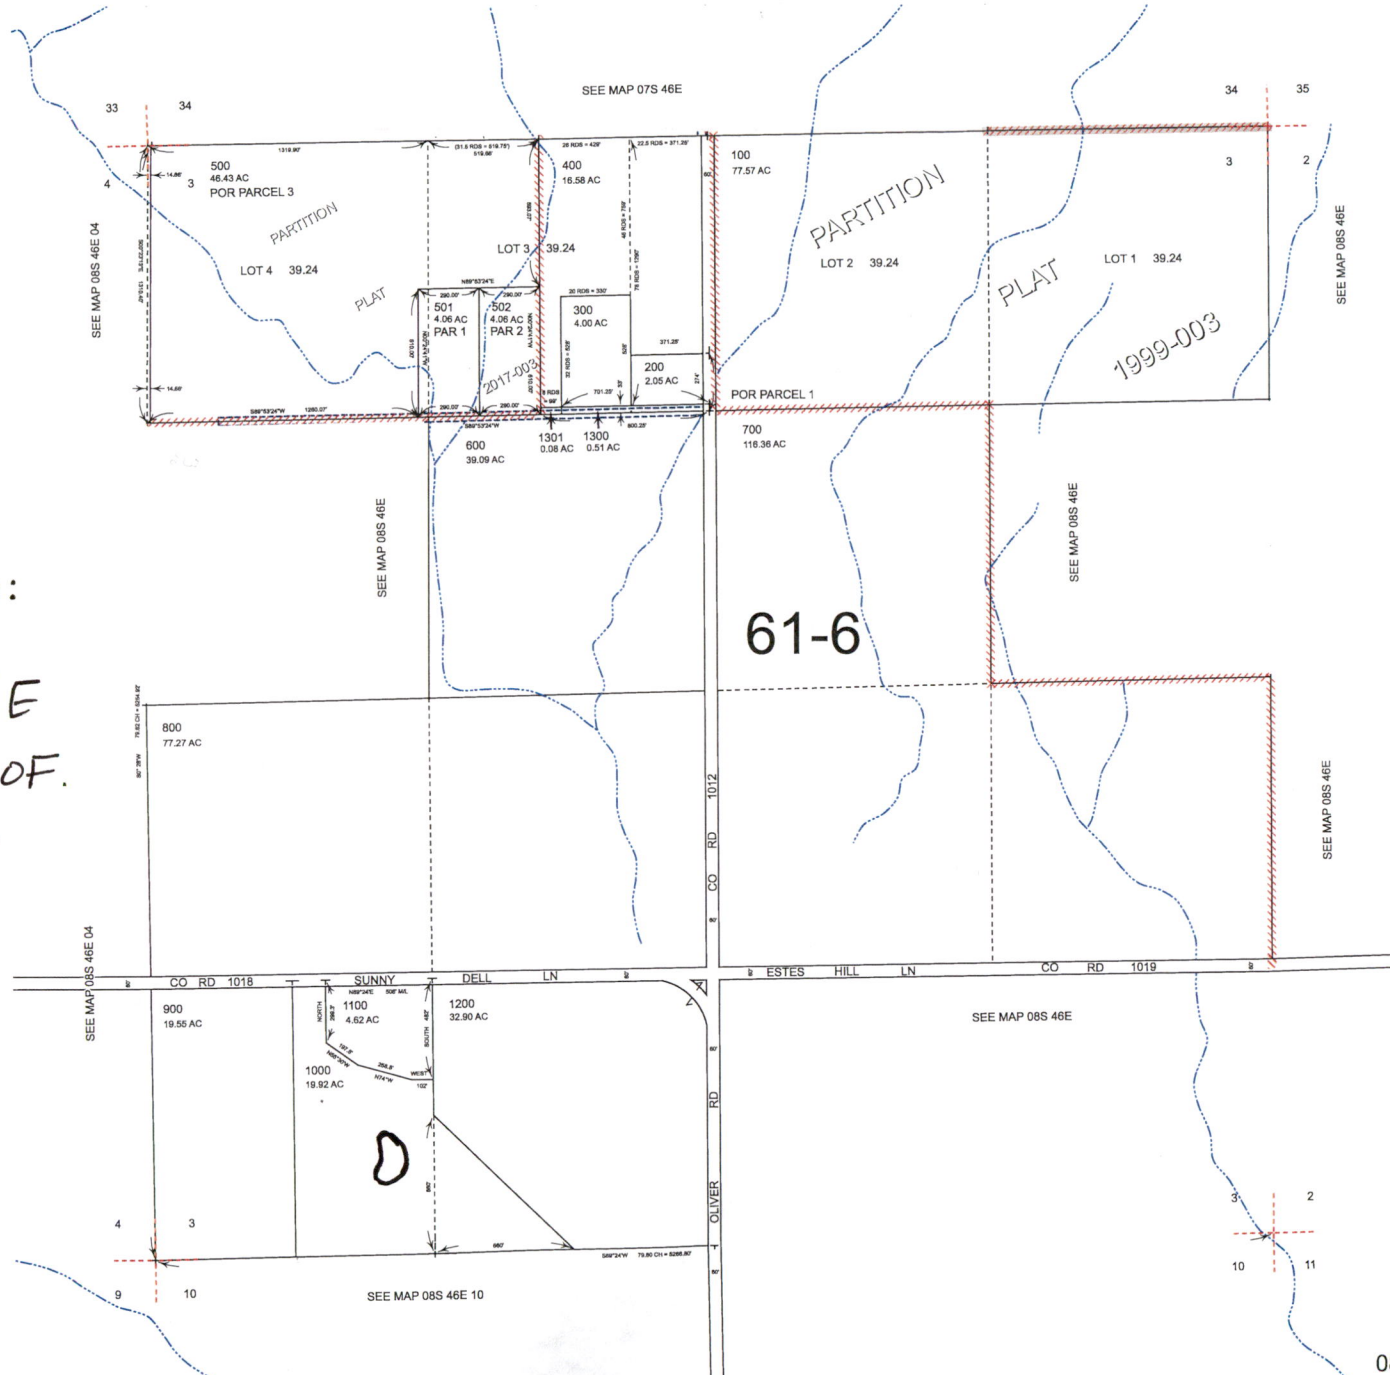

Revised: TK
09/15/2017

08S46E03

POND LOCATION:
370' N : 1086' E
FR. SW CORN OF.
TAX LOT 1000.