

VAN LOO
COLLECTOR POND



Received by OWRD

APR 09 2024


Salem, OR

THIS APPLICATION MAP
WAS PREPARED FOR THE
PURPOSE OF IDENTIFY THE
LOCATION OF A WATER
RIGHT ONLY & IS NOT
INTENDED TO PROVIDE
LEGAL DIMENSIONS OR
LOCATIONS OF PROPERTY
OWNERSHIP LINES.

Received by OWRD

FEB . 2024

Salem, OR

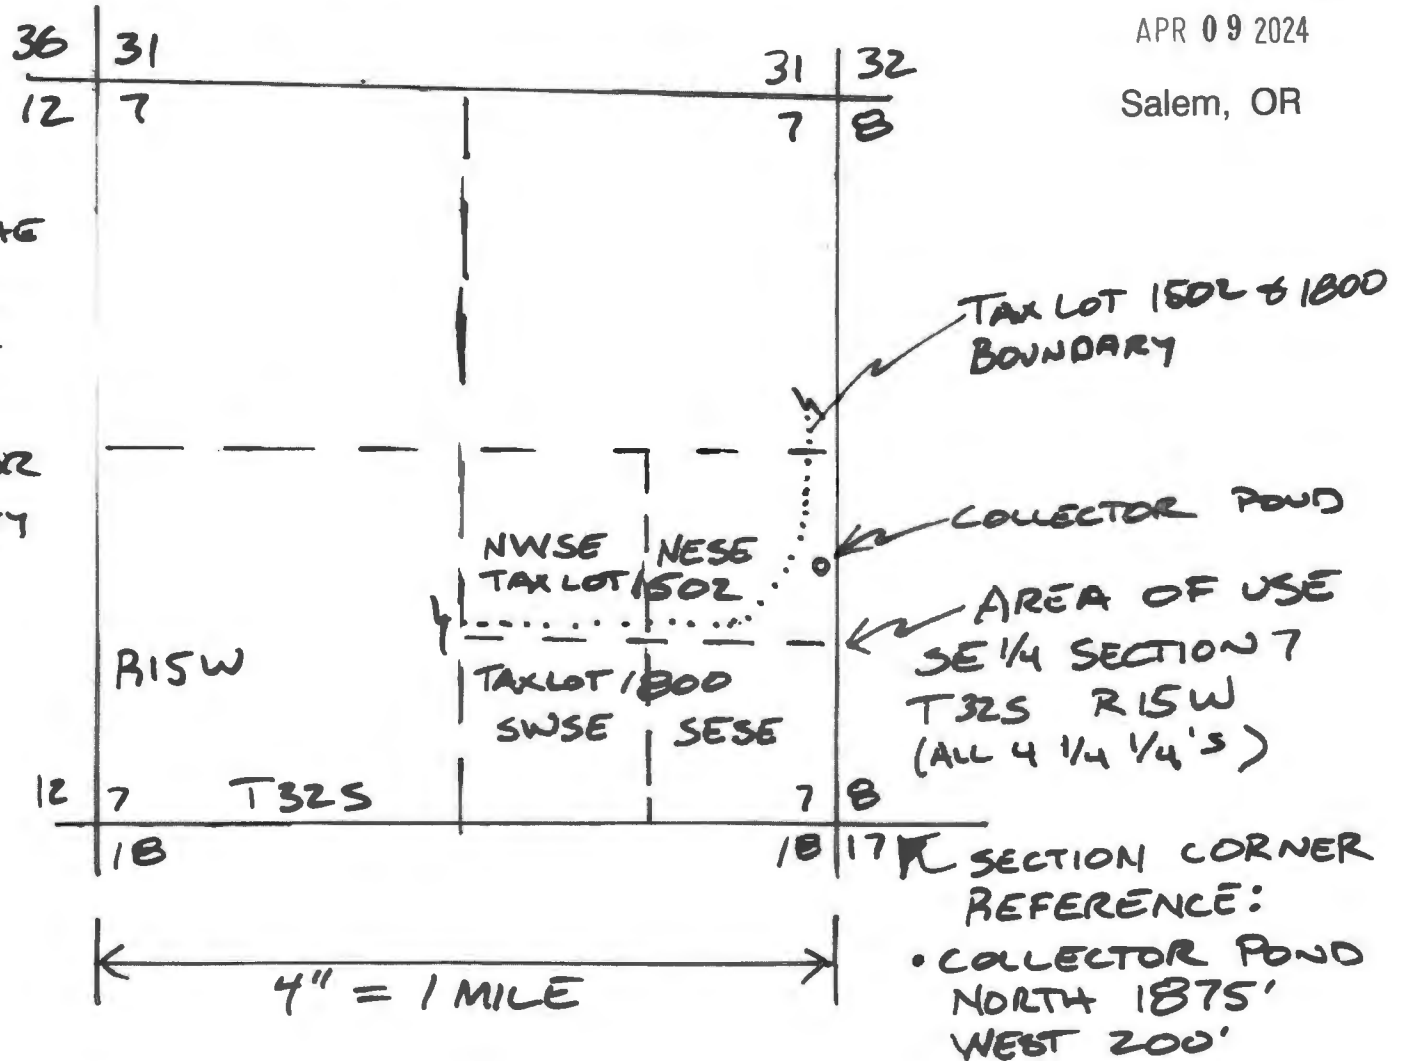

Tom GRUSZCZENSKI 12/04/2023