


- Well & Meter
- POU IS Well 2 & New Well (1-4-1995 Priority)
- POU IS Well 1 & New Well (1-4-1995 Priority)
- POU IS Well 1 & New Well (8-14-1962 Priority)
- Section
- Tax Lot
- - - - - QQ

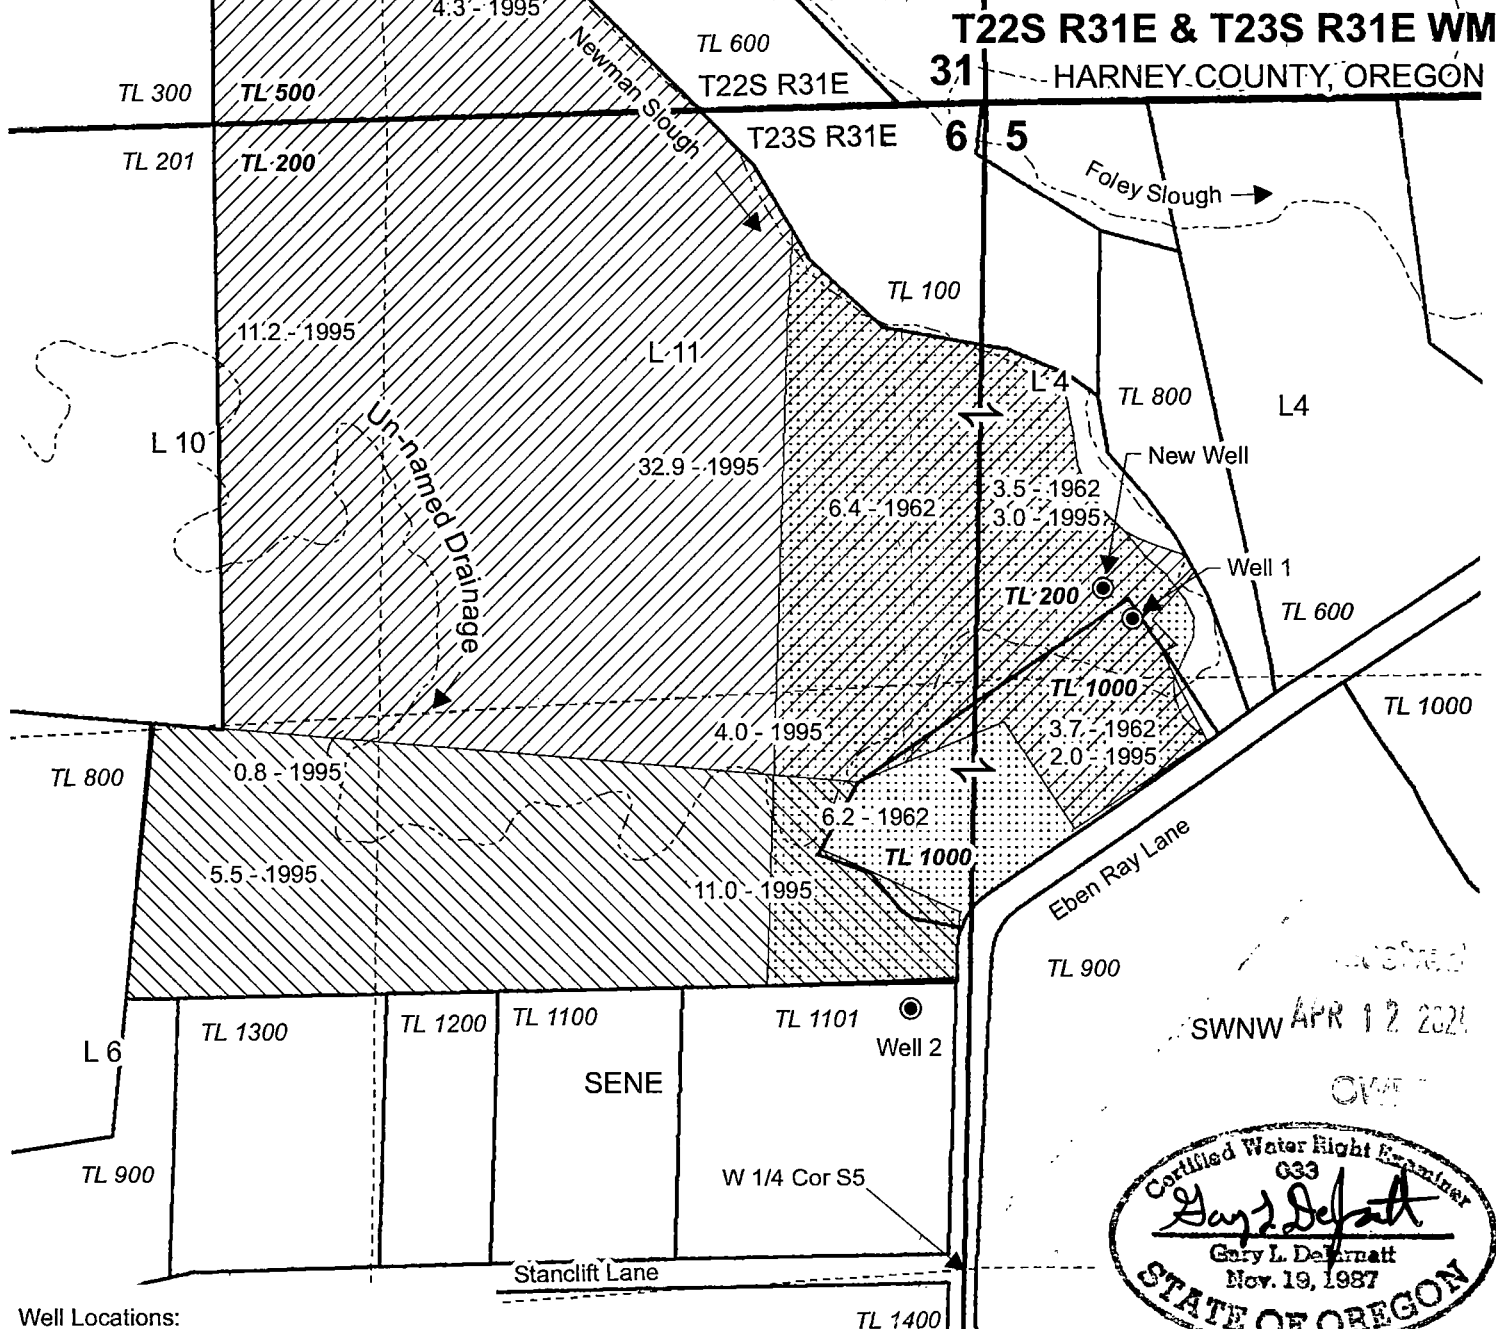

SWNW APR 12 2021  
 OWE

Well Locations:  
 Well 1 (HARN 50310/L-21286): 1071' S, 296' E of NW Cor S 5  
 Well 2 (HARN 50601): 1809' S, 285' W of NE Cor S 6  
 New Well (HARN 52711/L-128171): 1350' N, 330' E of W 1/4 Cor S 5

RENEWAL DATE 12/31/2025

**CLAIM OF BENEFICIAL USE MAP**  
 White Hereford Ranch, Inc.  
 T-12903

NOTE: THIS MAP IS NOT INTENDED TO PROVIDE LEGAL DIMENSIONS OR LOCATIONS OF PROPERTY OWNERSHIP LINES.  
 Project #23074 Date: 3/12/2024

**WATER RIGHT SERVICES, LLC**  
 PO BOX 1830, BEND, OR 97709  
 CCB# 197121 www.oregonwater.us  
 541-389-2837 JOHNSHORT@USA.COM