
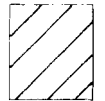


T.9 S., R.1W., W.M.

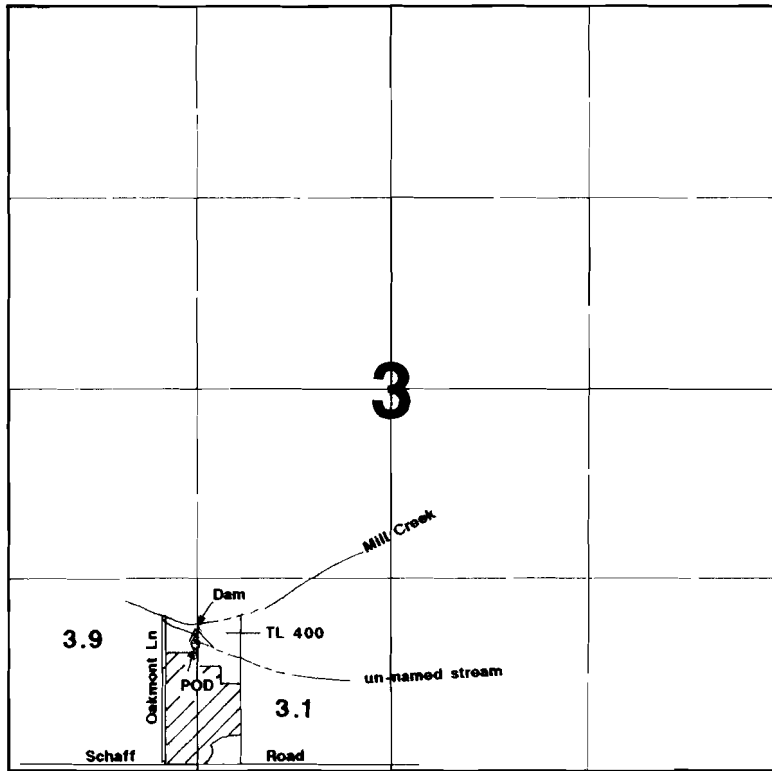

Area Irrigated

Dam & POD are located 870'N & 1290' E from the SW corner of Section 3.

Final Proof Survey

In the Name of

Don Harteloo

Application #: R-84320 Permit #: R-13084
Application #: S-84321 Permit #: 53750

Surveyed on September 1, 2004 by JM Schuette

This Map was Prepared for the Purpose of Identifying the Location of a Water Right Only and is Not Intended to Provide Legal Dimensions or Location of Property Ownership Lines

