

CLAIM OF BENEFICIAL USE FINAL PROOF MAP

LOCATED IN THE NW¼ NW¼, NE¼ NW¼ & SE¼ NE¼
of SECTION 10, TOWNSHIP 33 SOUTH, RANGE 15 WEST, WM..
CURRY COUNTY, OREGON

APPLICATION # S-72295 PERMIT # 51876
APPLICATION # R-72294 PERMIT # R-11990


PREPARED FOR: IRA ANDERSON
PREPARED BY: DENNIS GOUDE
SURVEYED: AUGUST 21, 2000

RECEIVED

SEP 20 2000

WATER RESOURCES DEPT.
SALEM, OREGON

1" = 1320 FEET

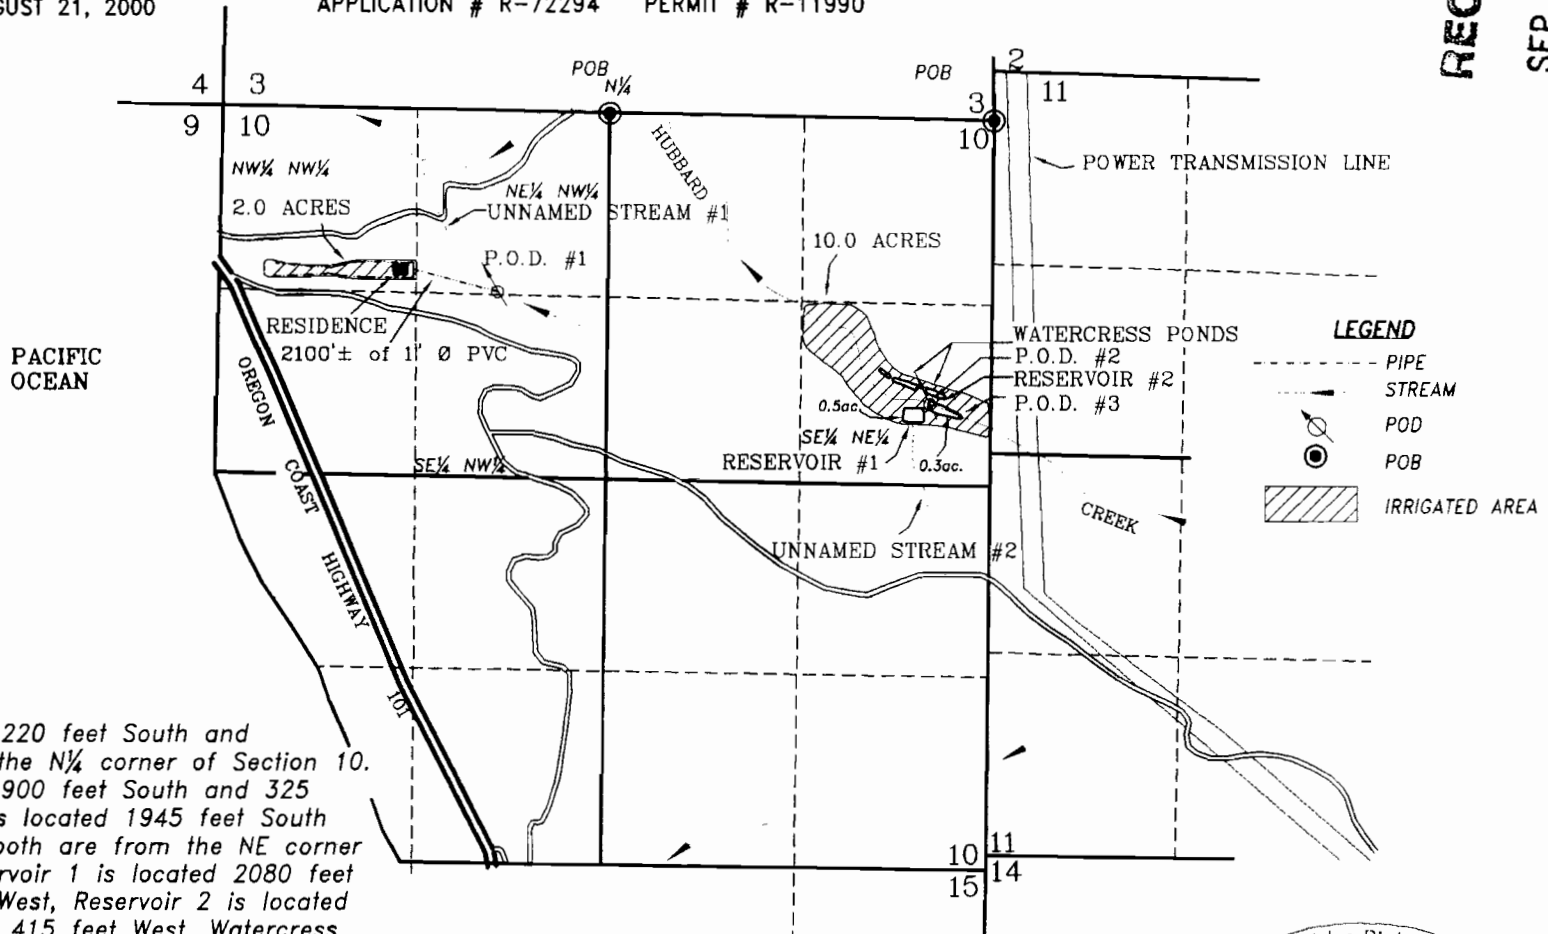

NOTE:

P.O.D. 1 is located 1220 feet South and 762 feet West from the N¼ corner of Section 10. P.O.D. 2 is located 1900 feet South and 325 feet West, P.O.D. 3 is located 1945 feet South and 375 feet West, both are from the NE corner of Section 10. Reservoir 1 is located 2080 feet South and 455 feet West, Reservoir 2 is located 1990 feet South and 415 feet West, Watercress Habitat pools are located 1900 feet South and 580 feet West. All distances are from the NE corner of Section 10, Township 33 South, Range 15 West, WM..

**Stuntzner Engineering
& Forestry, LLC**

ENGINEERING * LAND SURVEYING * FORESTRY
PLANNING * WATER RIGHTS

705 South 4th St.
Post Office Box 118
Coos Bay, Oregon 97420

Phone (541) 267-2872
Fax (541) 267-0588

EXAMINERS DISCLAIMER STATEMENT

The preparation of this map was for the purpose of identifying the location of the Water Right only and has no intent to provide dimensions or location of property ownership lines.



EXPIRES 06/30/02