


FINAL PROOF SURVEY MAP
IN THE NAME OF LAUREL CREEK ACRES, LLC

IN

TOWNSHIP 29 SOUTH, RANGE 14 WEST, W.M.

APPLICATION R - 72309
S - 72310

PERMIT R - 11618
51859

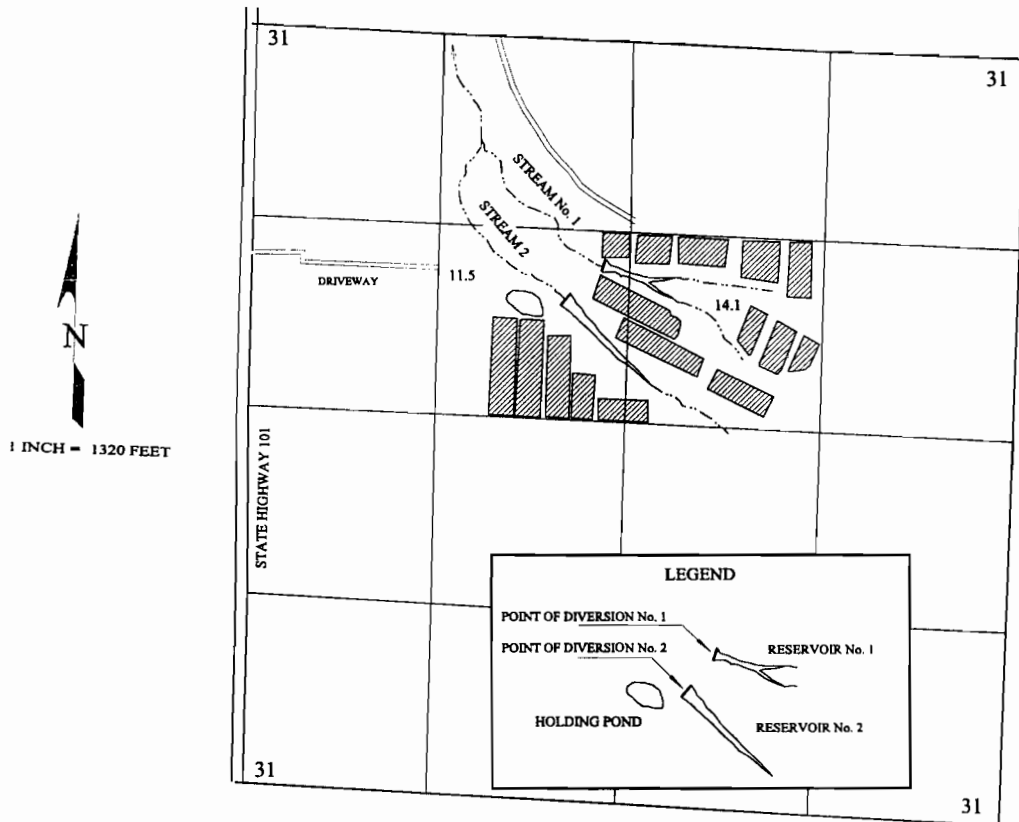

POINT OF DIVERSION No. 1 IS LOCATED 1,550 FEET SOUTH AND 200 FEET WEST AND POINT OF DIVERSION No. 2 IS LOCATED 1,780 FEET SOUTH AND 470 FEET WEST; BOTH FROM THE NORTH QUARTER CORNER OF SECTION 31 AND ARE LOCATED WITHIN THE SE $\frac{1}{4}$ NW $\frac{1}{4}$ OF SECTION 31, TOWNSHIP 29 SOUTH, RANGE 14 WEST, W.M.; COOS COUNTY.

RECEIVED

AUG 22 2000

WATER RESOURCES DEPT
SALEM, OREGON

THE PURPOSE OF THIS MAP IS TO IDENTIFY THE LOCATION OF THE WATER RIGHT.
IT IS NOT INTENDED TO PROVIDE INFORMATION RELATIVE TO THE LOCATION OF
PROPERTY OWNERSHIP BOUNDARY LINES.