

NOTE: THIS MAP IS NOT INTENDED TO PROVIDE LEGAL DIMENSIONS OR LOCATIONS OF PROPERTY OWNERSHIP LINES.

DESCHUTES COUNTY, OREGON

**TOWNSHIP 17 SOUTH
RANGE 14 EAST,
WILLAMETTE MERIDIAN**

SECTION 26

NE 1/4 NW 1/4


TAX LOT 402

APPLICATION G-15635


PERMIT G-15616

JUL 13 2012

WATER RESOURCES DEPT
SALEM, OREGON

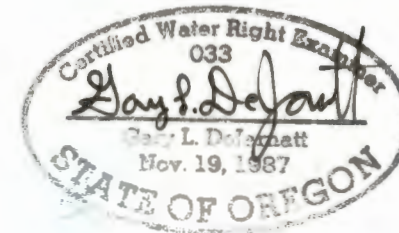

RENEWAL DATE: 12-31-2013

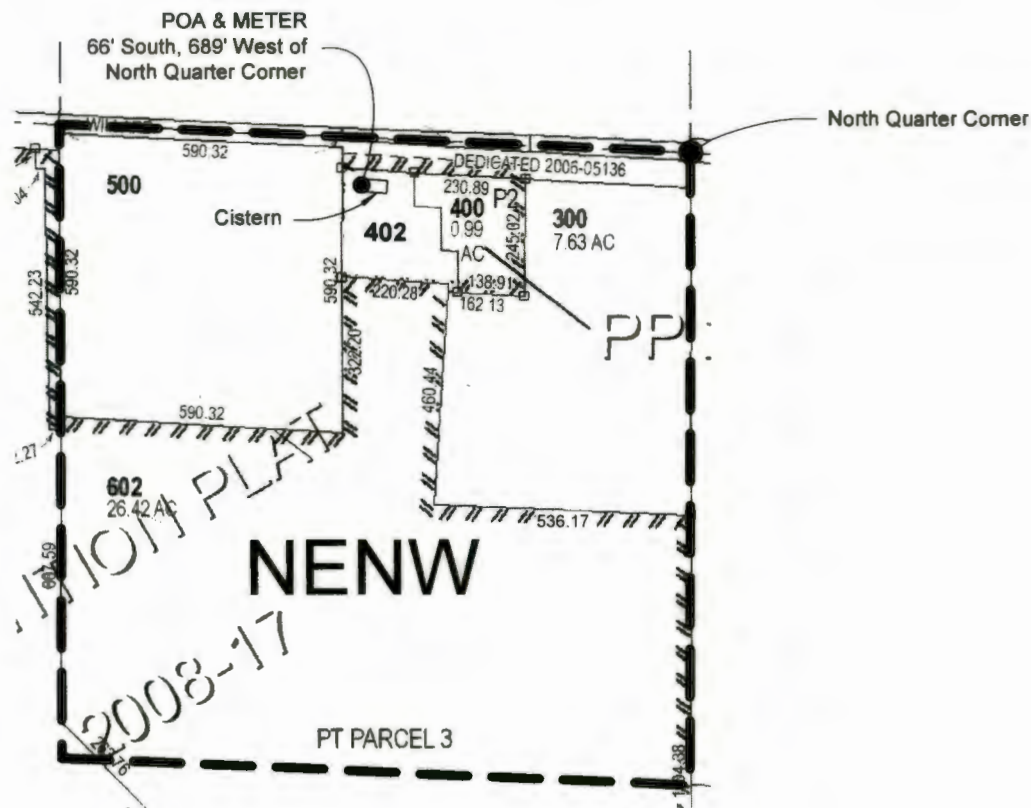

QUARTER QUARTER BOUNDARY

TITLE

CLAIM OF BENEFICIAL USE MAP for
CLAUDIA G. GREEN

WATER RIGHT SERVICES, LLC
P.O. BOX 1830, BEND OR 97709

WWW.OREGONWATER.US
(541) 389-2837 CCB# 197121

DATE
JULY 2, 2012

JOHNSHORT@USA.COM

SHEET
1 OF 1

JOB# 12031