

Name Paul S. & Pearl C. Chambers
By _____
Address 2100 River Loop #1
Eugene, Oregon

Application No. GR 2100
Certificate No. GR 2017

Stream Index, Page No. 2-932 ✓

16/4W-35R

FEEES PAID

Date	Amount	Receipt No.
<u>7-14-58</u>	<u>15.00</u>	<u>17626</u>

Date filed July 14, 1958 8:00 AM
Tentative priority Feb. 15, 1952
Action suspended until _____

FEEES REFUNDED

Date	Amount	Check No.

Well log filed _____

ASSIGNMENTS

Date	To Whom	Address	Volume	Page

CONSTRUCTION

Date for completion _____
Extended to _____
Date for application of water _____
Extended to _____

REMARKS


A well irrigates 12² acres near Willamette River - Lane County

PROSECUTION OF WORK

Form "B" filed _____
Form "C" filed _____

Township 16S Range 10W, W.M.

North

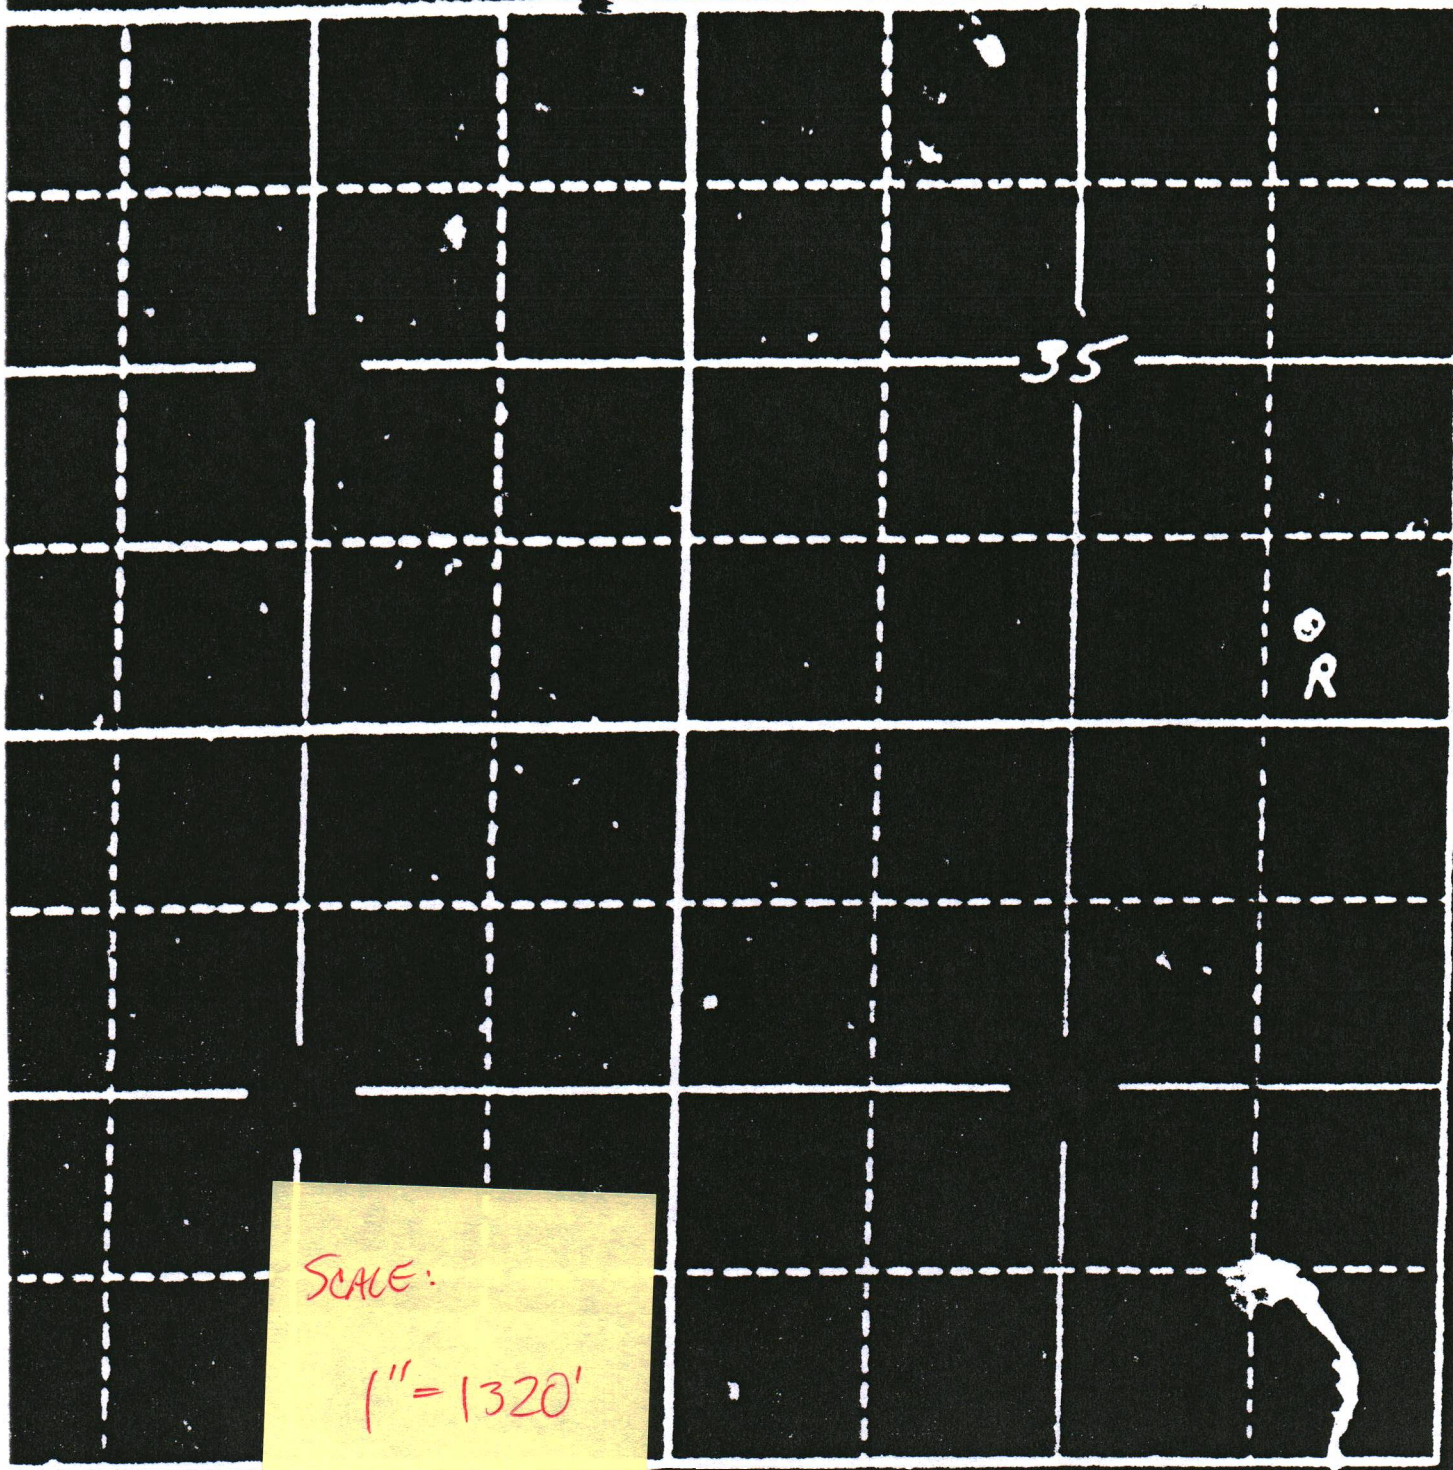

SCALE:
 1" = 1320'

Locate of irrigated land on plat.
 2" = 1 Mile

} ss.

Registration Statement

OF CLAIMANT OF RIGHT TO APPROPRIATE GROUND WATER

TO THE STATE ENGINEER OF OREGON:

I, Paul Chamberlain
of 2100 River Loop # One Eugene County of Lane
(Mailing address)

State of Oregon, do hereby make application for a certificate of registration as evidence of a right to appropriate ground water.

- Source from which water is withdrawn is Drain Well
(Flowing well, pump well, infiltration trench, or tunnel)
- Location is: 8 mi N of Eugene
(Approximate distance and direction from nearest city or town)

and is more particularly described as follows:

(a) 1070' W & ⁵⁵⁰/₅₀₀' N from SE CORNER SEC 35
(Give distance and bearing to corner of section or other legal subdivision)
being within SE/SE of Sec. 35 Twp. 16 S Rge. 4 W
(Smallest legal subdivision) (N or S) (E or W)

or (b) within limits of recorded platted property, town or city

in Lot _____ Block _____ of _____
(Name of plat or addition)

County of _____
(If within city or town, give name)

3. Construction Work was begun on Feb 12, 1954 was completed on Feb 15, 1952
(Date) (Date)

and the ground water claimed was first used for the purposes set out below on Aug 2, 1952
(Date)

since which time the water has been used Intermittently
(Continuously or Intermittently)

from Aug 2, 1952 to Sept 1, 1957
(Date) (Date)

4. Quantity of water claimed and used is 140 gallons per minute, 30 acre feet per year.

5. Purpose or Purposes for which water is used Irrigation
(Domestic, irrigation, municipal, manufacturing, industrial, etc.)

6. Description of Well: Depth 31 feet. Type driven
(Dug or drilled)
diameter 2-2 1/2 inches. Elevation of ground at well site 300 feet, mean sea level.
(As near as known)
Depth to water table 14 feet.

7. Capacity of Well: _____ g.p.m. with _____ feet drawdown
_____ g.p.m. with _____ feet drawdown

Date of test Mo

If Flowing Well: Measured discharge _____ g.p.m. on _____
(Date)

Shut-in pressure at ground surface _____ lbs. per sq. in. on _____
(Date)

Water is controlled by _____
(Cap, valve, etc.)

If log of well is not available, give name and address of driller, Elmer Emerson

11. Infiltration Trench: Covered or open _____
 Dimensions: Length _____ ft. Minimum depth _____ ft. Maximum depth _____ ft.
 Bottom width _____ ft. Discharge _____ g.p.m. Date of test _____

12. Tunnel: Type of lining _____
 Dimensions: _____
(Length, cross, and area sectional size)
 Position of water bearing stratum with reference to portal of tunnel _____

Log of tunnel: (Preceding table for log of well may be used, if desired. Give footage from portal and character of materials, as pertinent.)

13. Pumping Equipment:
 (a) Pump Berkley Centrif. Capacity 275 g.p.m.
(Make, type and size)
 (b) Motor 10 H 3 φ Elec
(Type and horsepower)


14. Location of area irrigated or to be irrigated, or place of use if for purposes other than irrigation.

Township North or South	Range E. or W. of Meridian	Section	Part-of-acre Tract	Number Acres To Be Irrigated	Date of Reclamation
165	4W	35	SW/SE	3.7	1952
"	"	"	SE/SE	7.5	"
175	4W	2	NW/NE	0.4	"
"	"	"	NE/NE	0.8	"
				12.2	

15. If the ground water supply is supplemental to an existing water supply, identification of any application for a permit, permit, certificate or adjudicated right to appropriate water made or held by the registrant.

GR 2017

Township 16S Range 11W W.M.
North

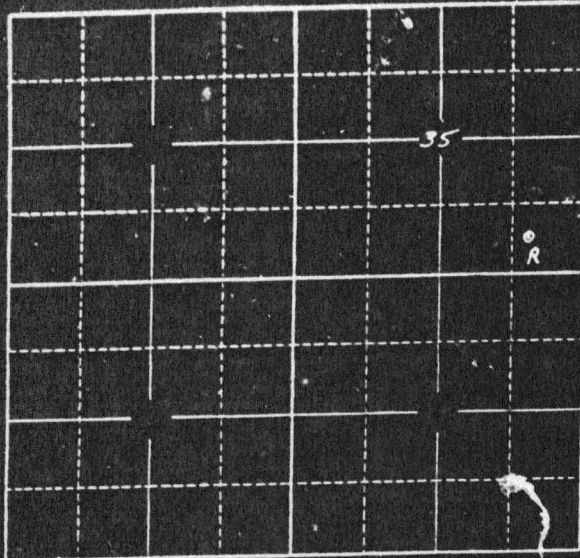

Locate well and acreage of irrigated land on plat.

Scale: 2" = 1 Mile

STATE OF OREGON

County of Tillamook } ss.

I, PALLS CHAMBERS, being first duly sworn, do hereby certify that I have read the foregoing Registration Statement and that all of the items therein contained are true to the best of my knowledge and belief.

(Signature of Registrant)

Subscribed and sworn to before me this 14 day of July, 1955

My commission expires June 25, 1961
(Notary Public)

(SEAL)

CERTIFICATE OF REGISTRATION

STATE OF OREGON } ss.
County of Marion

This is to certify that the foregoing Registration Statement was received in the office of the State Engineer on the 14 day of July, 1955, at 8:00 o'clock A.M. and has been duly recorded in said office in Book No. 9 of Registration Statements on page GR-2017

Witness my hand this 9th day of February, 1959

Lewis A. Stanley
(State Engineer)

By _____
(Deputy)

GR - 2017

GR-2100

February 26, 1959

Paul S. and Pearl C. Chambers
2100 River Loop #1
Eugene, Oregon

Dear Sir and Madam:

GR-2100
GR-2017