

RECEIVED

SEP 0 8 2000

T. 9S., R. 40E., W.M.

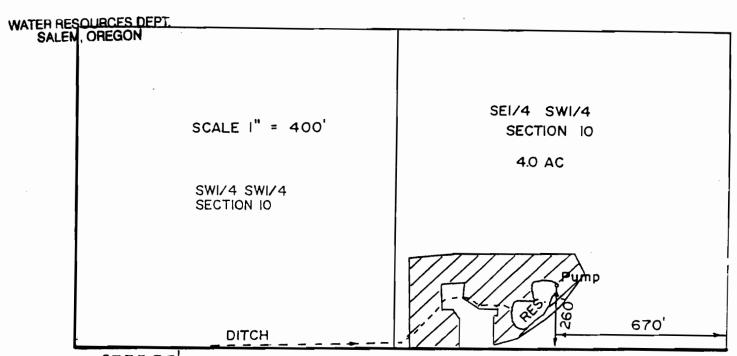

The purpose of this map is for identifying the location of the water right only and is not intended to provide legal dimensions of property ownership lines.

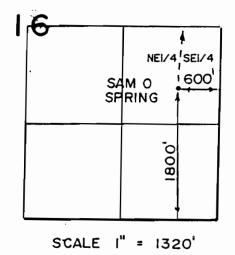

FINAL PROOF SURVEY

APPL. R-72331 72332

PER. R-11876 52492

IN NAME OF

Harold & Beverly Staten
Surveyed Aug. 22, 2000

