
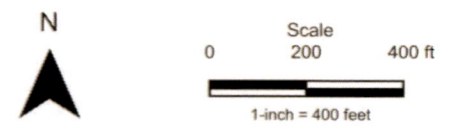


- LEGEND**
- Point of Appropriation (POA)
 - ▨ Place of Use (POU)
 - ▭ PLSS Sections
 - ▭ PLSS Quarter-Quarters
 - ▭ Tax Lots
 - Reservoir (Certificate 58421)
 - Water System Pump Station
 - Water System Mainlines
 - Perennial
 - Intermittent

POA Location Description

Well 1 (CLAC 57578)
 Located 540 feet South and 1280 feet West from NE corner of Section 21 (NENE), Township 1 South, Range 4 East, W.M.

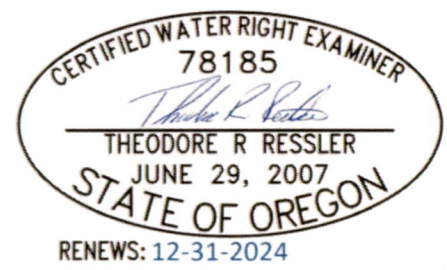

Date: 3/19/2024
 Data Sources: BLM, OGEO, USGS, OWRD, Metro, Multnomah Co.
 Disclaimer: This map is not intended to provide legal dimensions or property ownership lines.

Claim of Beneficial Use
 Permit G-15211, Application G-15498
 Water Right in Name of Surface Nursery, Inc.
 Multnomah County

Received
 APR 29 2024

OWRD

