
Location of irrigation: ~5 acres on lot 4-02 (highlighted) will be irrigated. (10 fruit trees, garden, home lawn) The pond will also be available for fire suppression.

Received
MAY 01 2024
OWRD

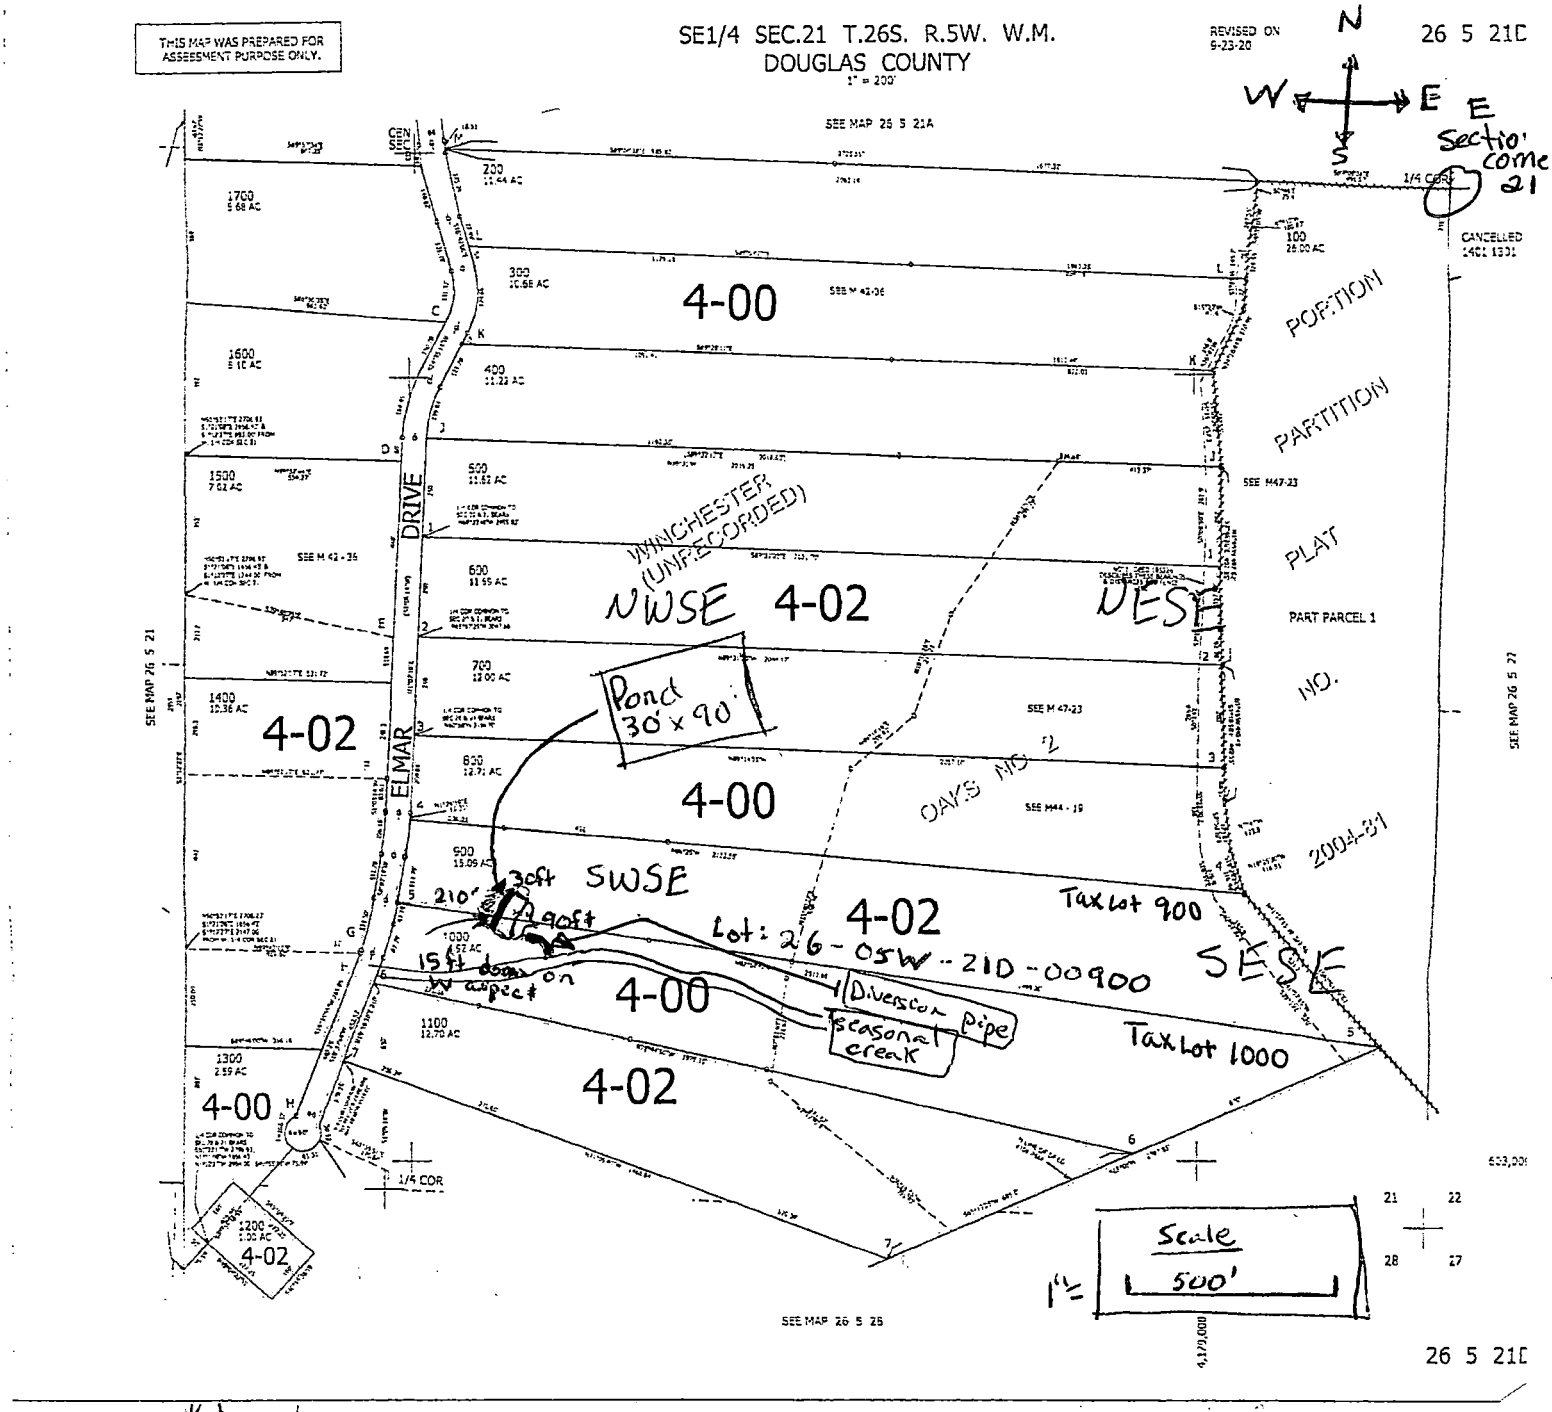


*Location:

Pond is 1879 ft South and 2376 ft west from the East 1/4 Section corner 21