


FINAL PROOF MAP

Application No. R-80119

Permit No. R-11638

T.11S., R.1E., W.M. SECTION 21

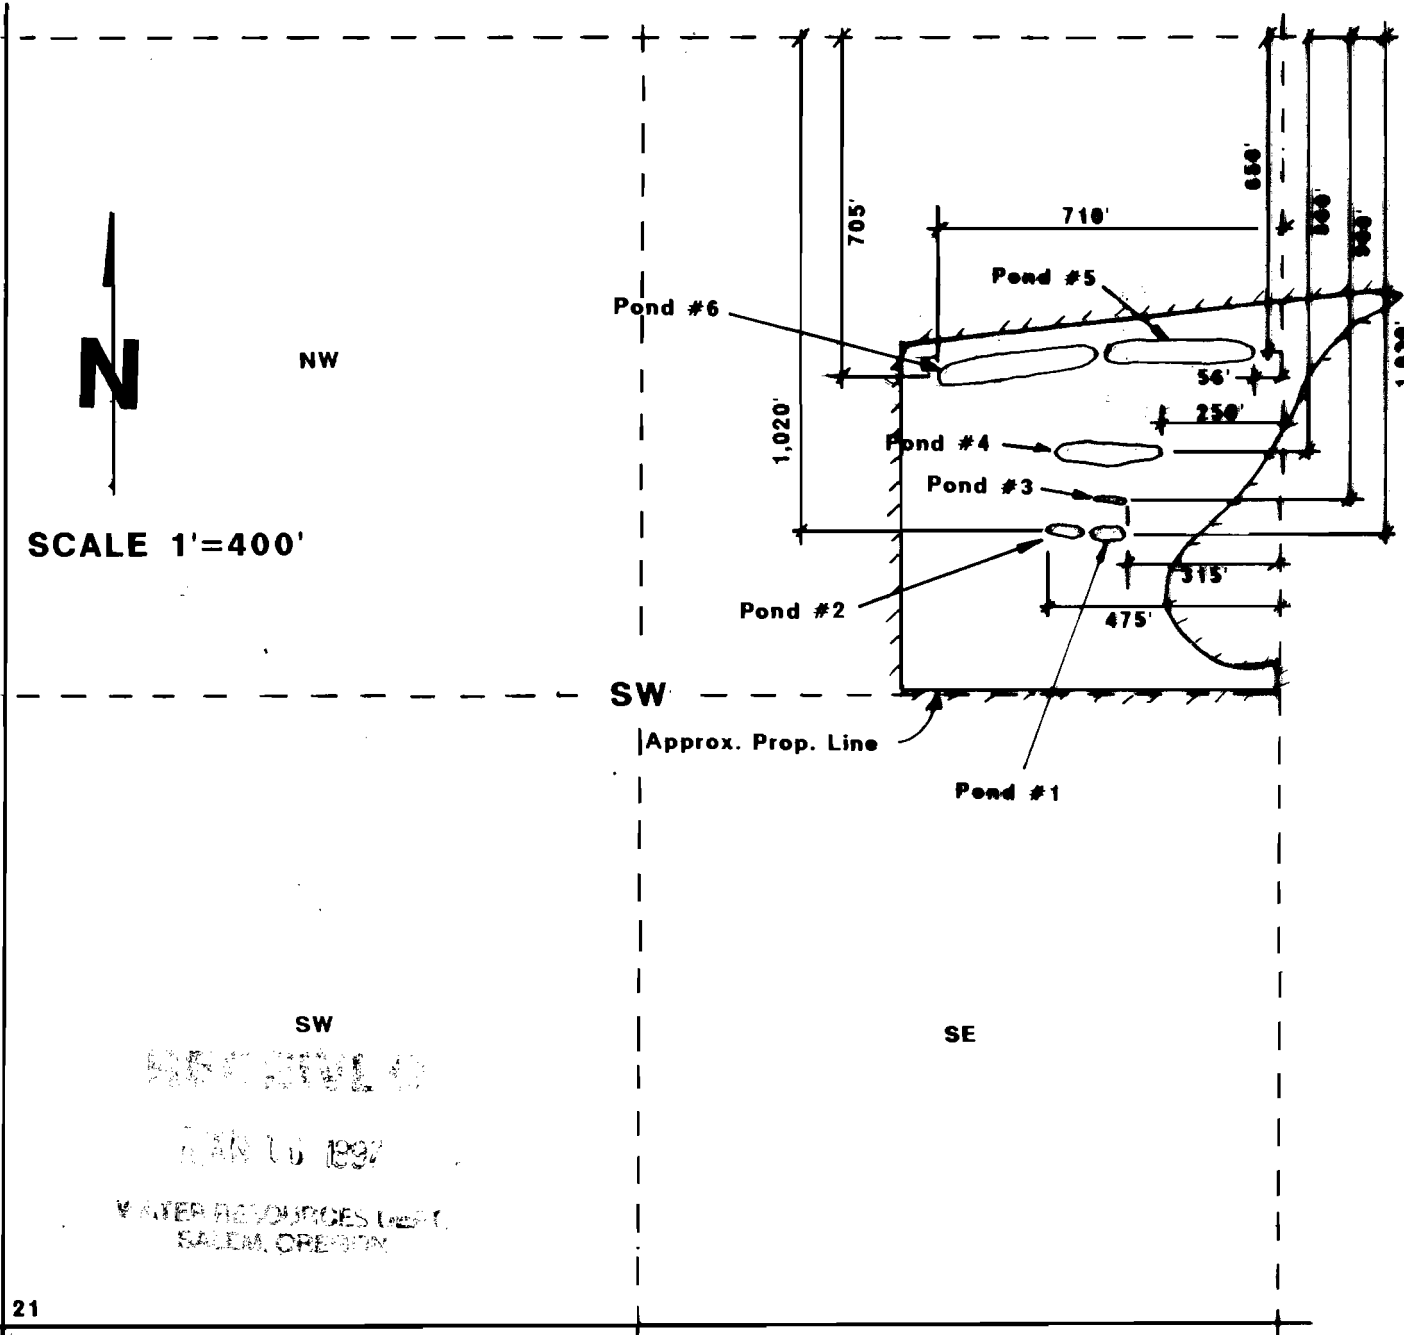

Note: Map is for the purpose of identifying location of water right and has no intent to dimension or locate property ownership lines.

Mrs. Jean Marshall
42961 Green Mt. Rd.
Lebanon, OR 97355

