


T. 8 S. R. 2 W. W.M.



S.W. COR.  
N. SHRUM  
DLC NO. 44

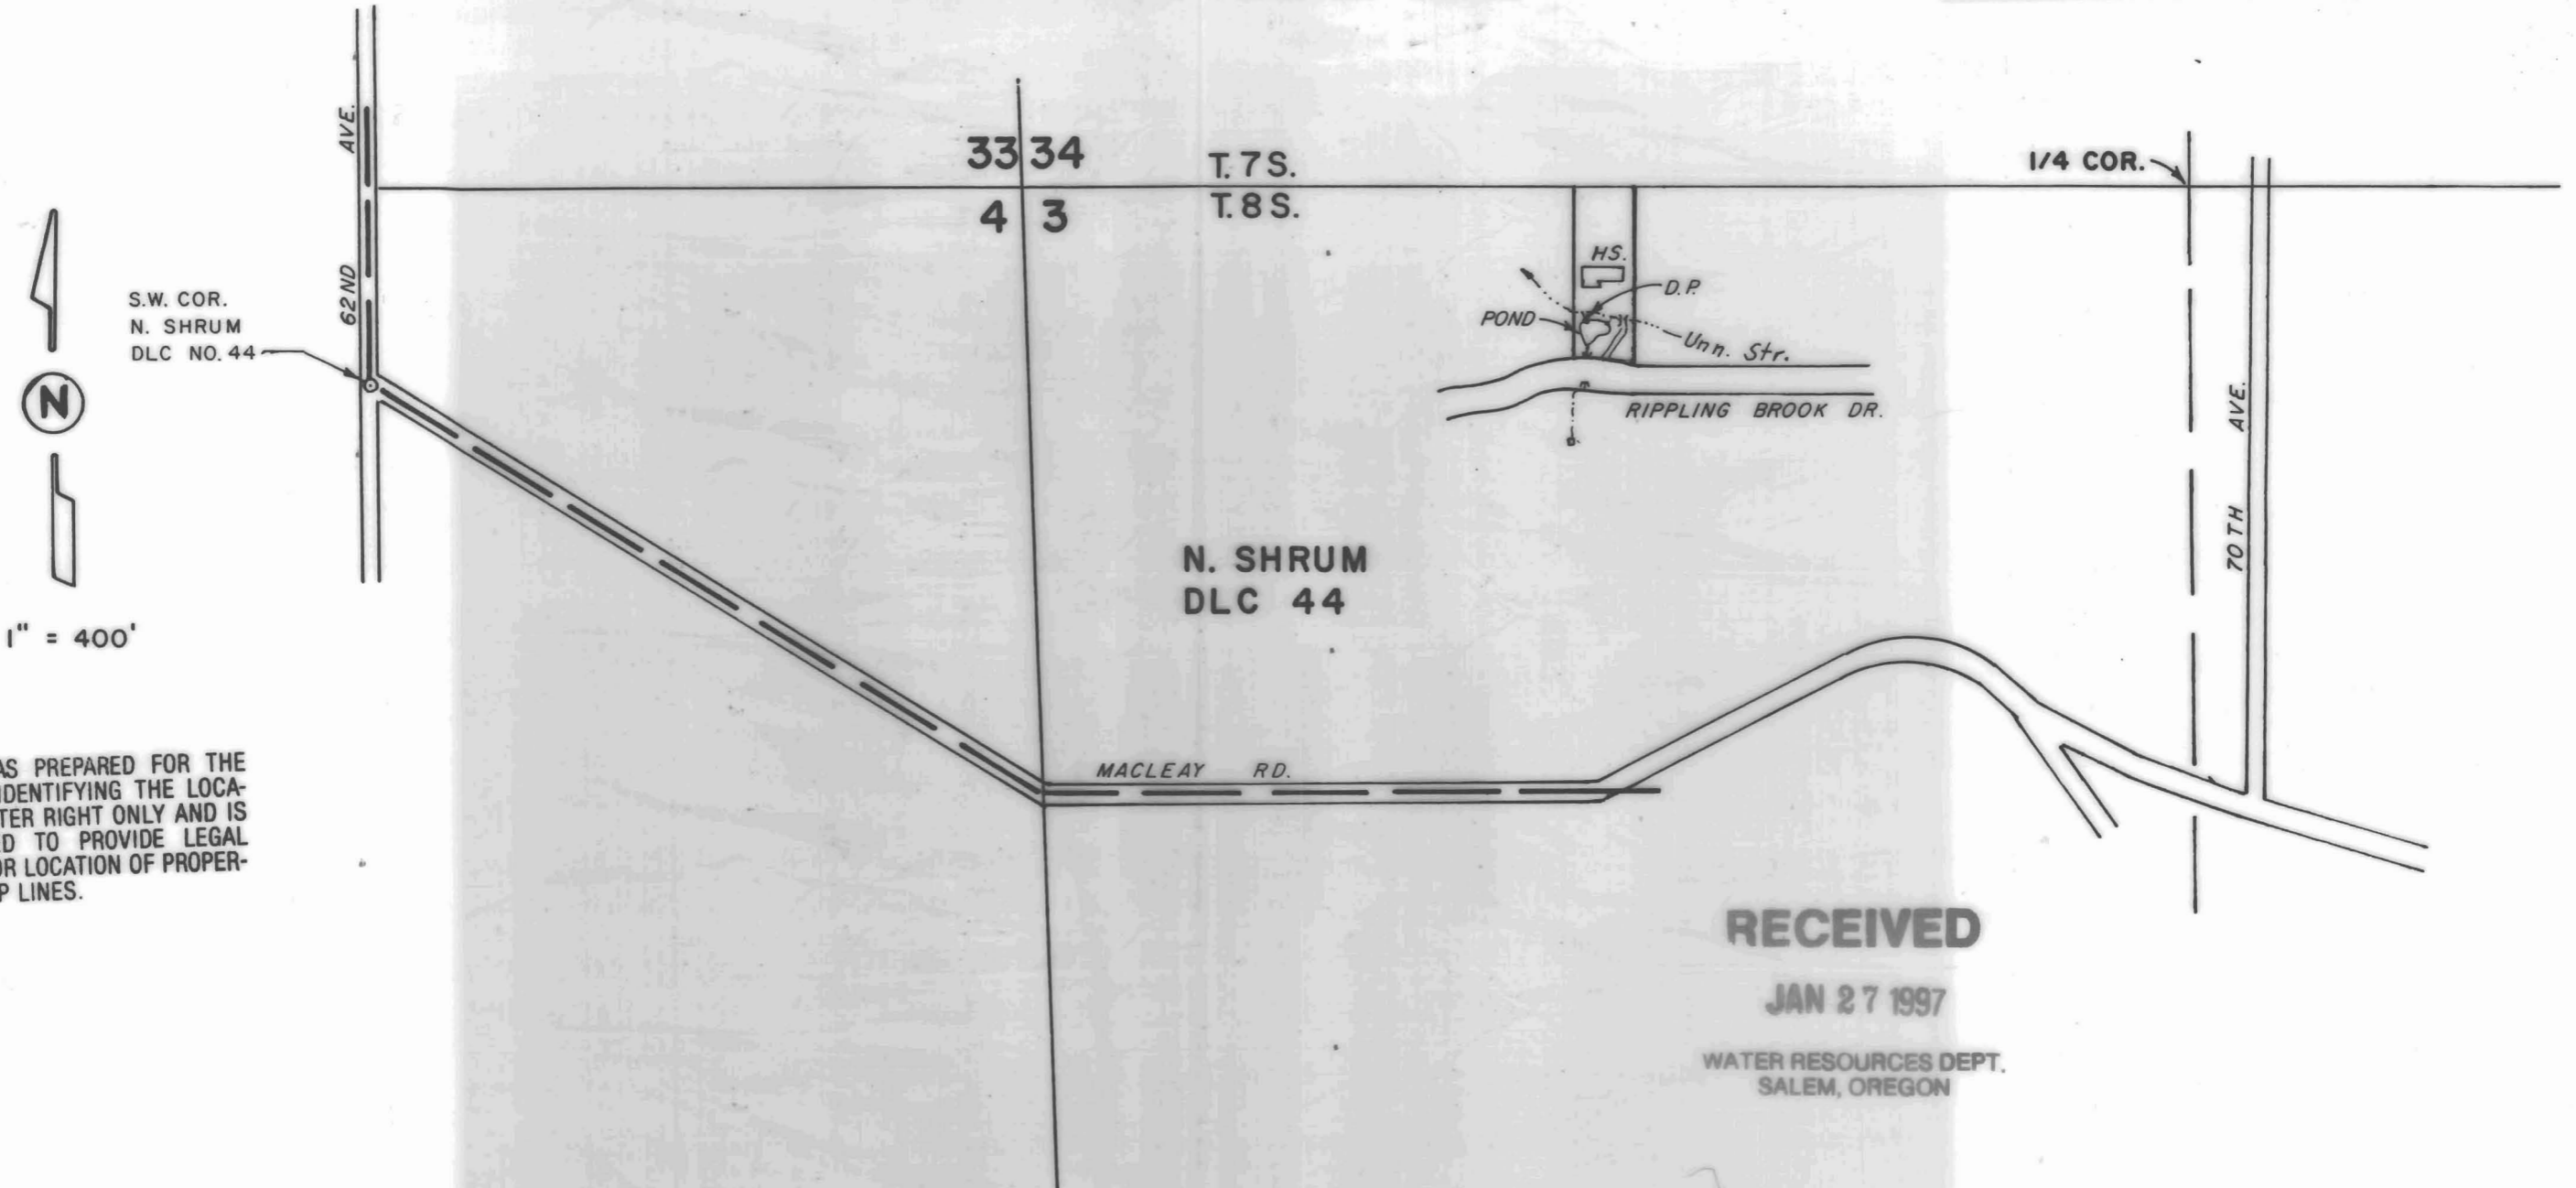

1" = 400'

THIS MAP WAS PREPARED FOR THE  
PURPOSE OF IDENTIFYING THE LOCA-  
TION OF A WATER RIGHT ONLY AND IS  
NOT INTENDED TO PROVIDE LEGAL  
DIMENSIONS OR LOCATION OF PROPER-  
TY OWNERSHIP LINES.

**RECEIVED**

JAN 27 1997

WATER RESOURCES DEPT.  
SALEM, OREGON

FINAL PROOF SURVEY FOR  
Appl. No. 72339 & R-72340  
Permit No. 51587 & R-11527

BY  
**JERRY TRACY**

Surveyed on Nov. 25, 1996 By

