



T. 8 S. R. 2 W. W.M.

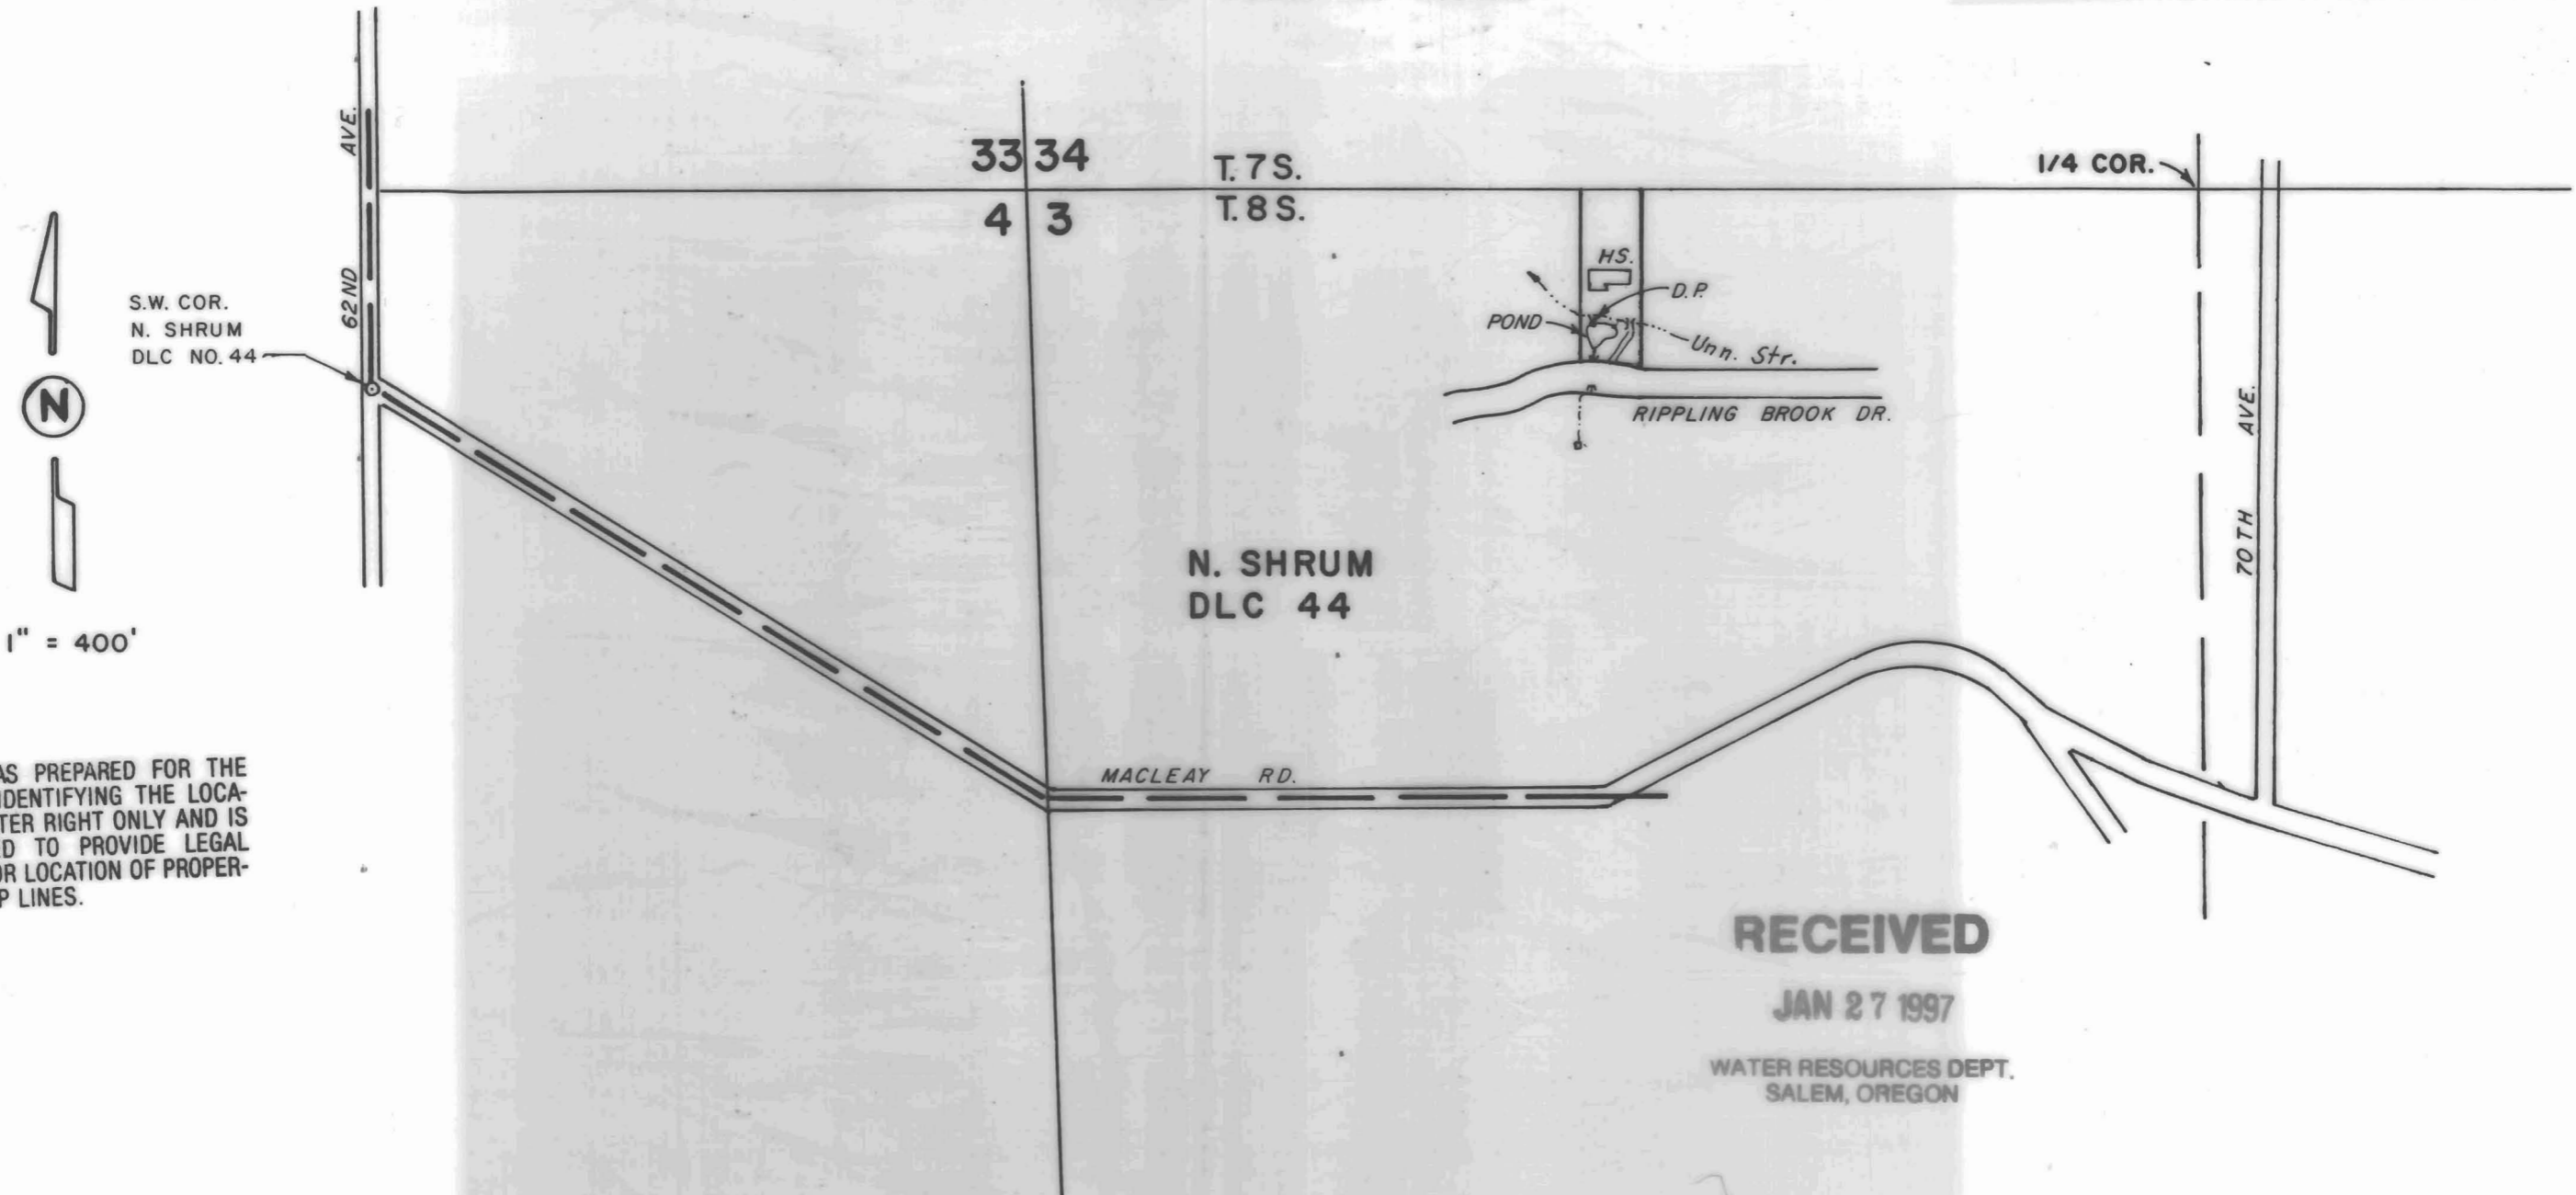

  
 S.W. COR.  
 N. SHRUM  
 DLC NO. 44  
 62ND AVE.  
 1" = 400'

THIS MAP WAS PREPARED FOR THE PURPOSE OF IDENTIFYING THE LOCATION OF A WATER RIGHT ONLY AND IS NOT INTENDED TO PROVIDE LEGAL DIMENSIONS OR LOCATION OF PROPERTY OWNERSHIP LINES.

**RECEIVED**

JAN 27 1997

WATER RESOURCES DEPT.  
SALEM, OREGON

FINAL PROOF SURVEY FOR  
 Appl. No. 72339 & R-72340  
 Permit No. 51587 & R-11527

BY  
**JERRY TRACY**

Surveyed on Nov. 25, 1996 By

