


SECTION 2, TWP.3 S. RANGE 16 E. W.M. SHERMAN COUNTY, OREGON

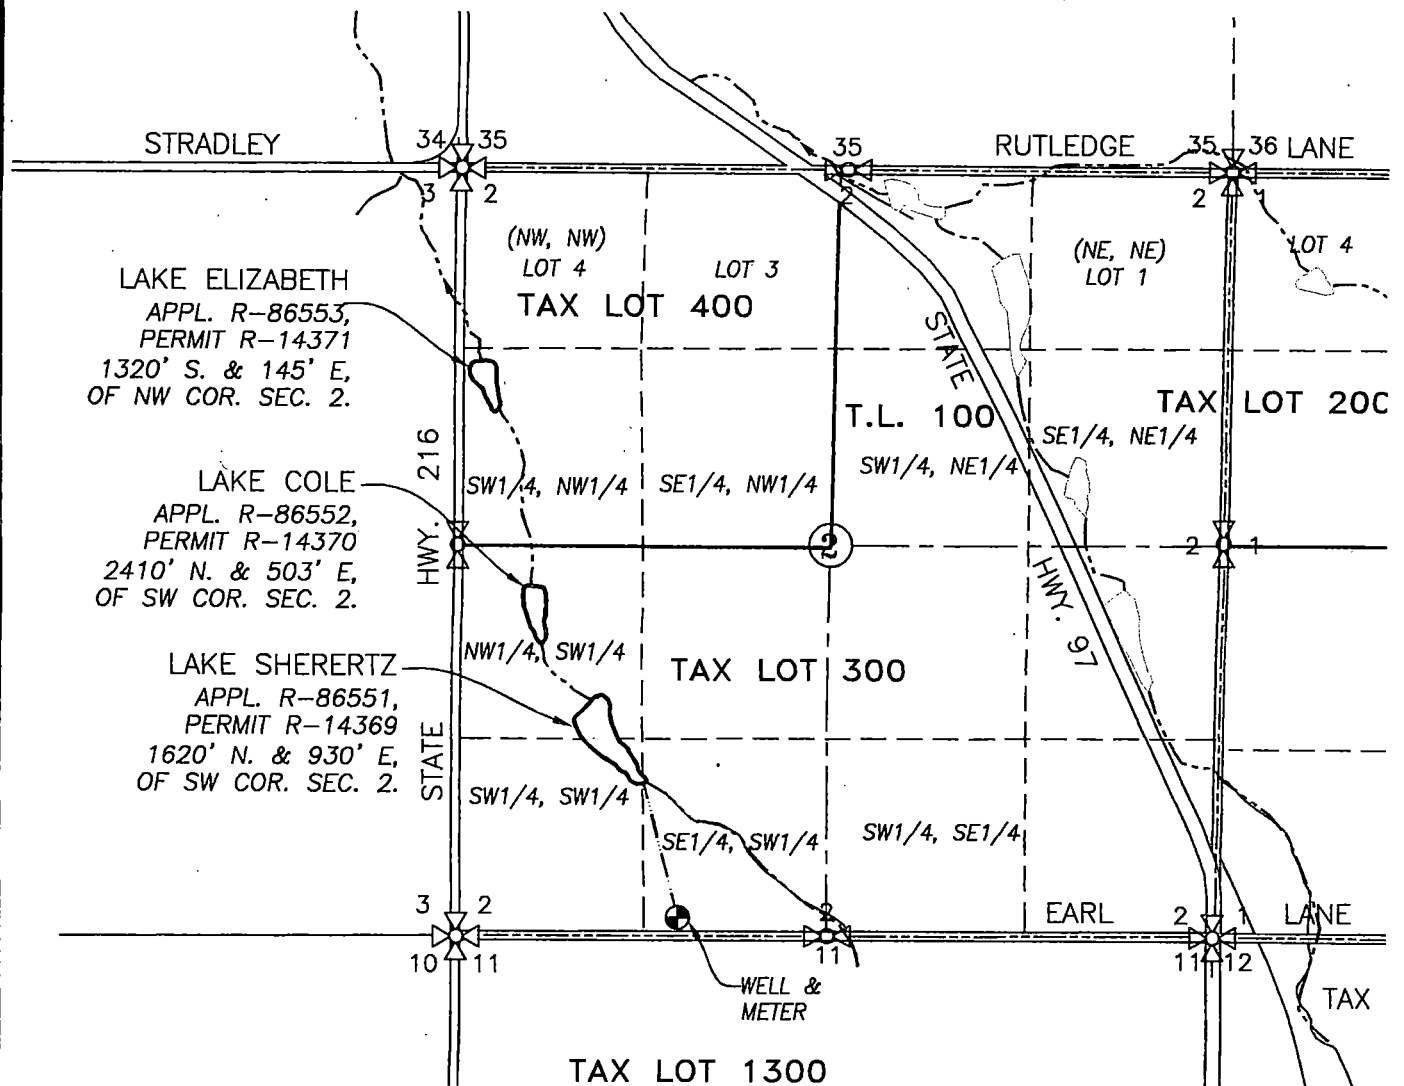

LEGEND :

- RESERVOIR (LAKE)
- STREAM WITH DIRECTIONAL FLOW
- 3" PVC PIPELINE
- WELL LOCATION 1524' EAST AND 120' NORTH OF SW CORNER, SECTION 2

CLAIM OF BENEFICIAL USE MAP

SCALE: 1" = 1320'

0' 660' 1320' 2640'

APPLICATION No. G-16659

PERMIT No. G-16193

IN THE NAME OF:

BUCK HOLLOW RANCH, INC.


DATE: MARCH 20, 2024

BY: **TENNESON ENGINEERING CORP.**

3775 CRATES WAY
THE DALLES, OREGON. 97058
PH. 541-296-9177
FAX 541-296-6657



Received
APR 29 2024
Received
MAY 08 2024
OWRD

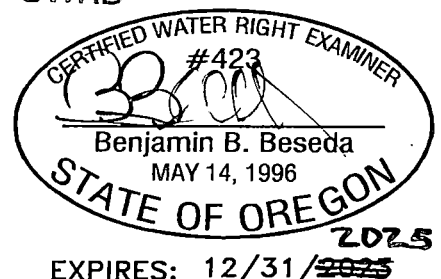

NOTE:

"THIS MAP IS NOT INTENDED TO PROVIDE LEGAL DIMENSIONS OR LOCATIONS OF PROPERTY OWNERSHIP LINES."

TEC W.O. #12028
AKS W.O. #10838