


THE WEST 1/2, SEC. 1 & E1/2, SEC. 2,
TOWNSHIP 3 S. RANGE 16 E. W.M.
SHERMAN COUNTY, OREGON

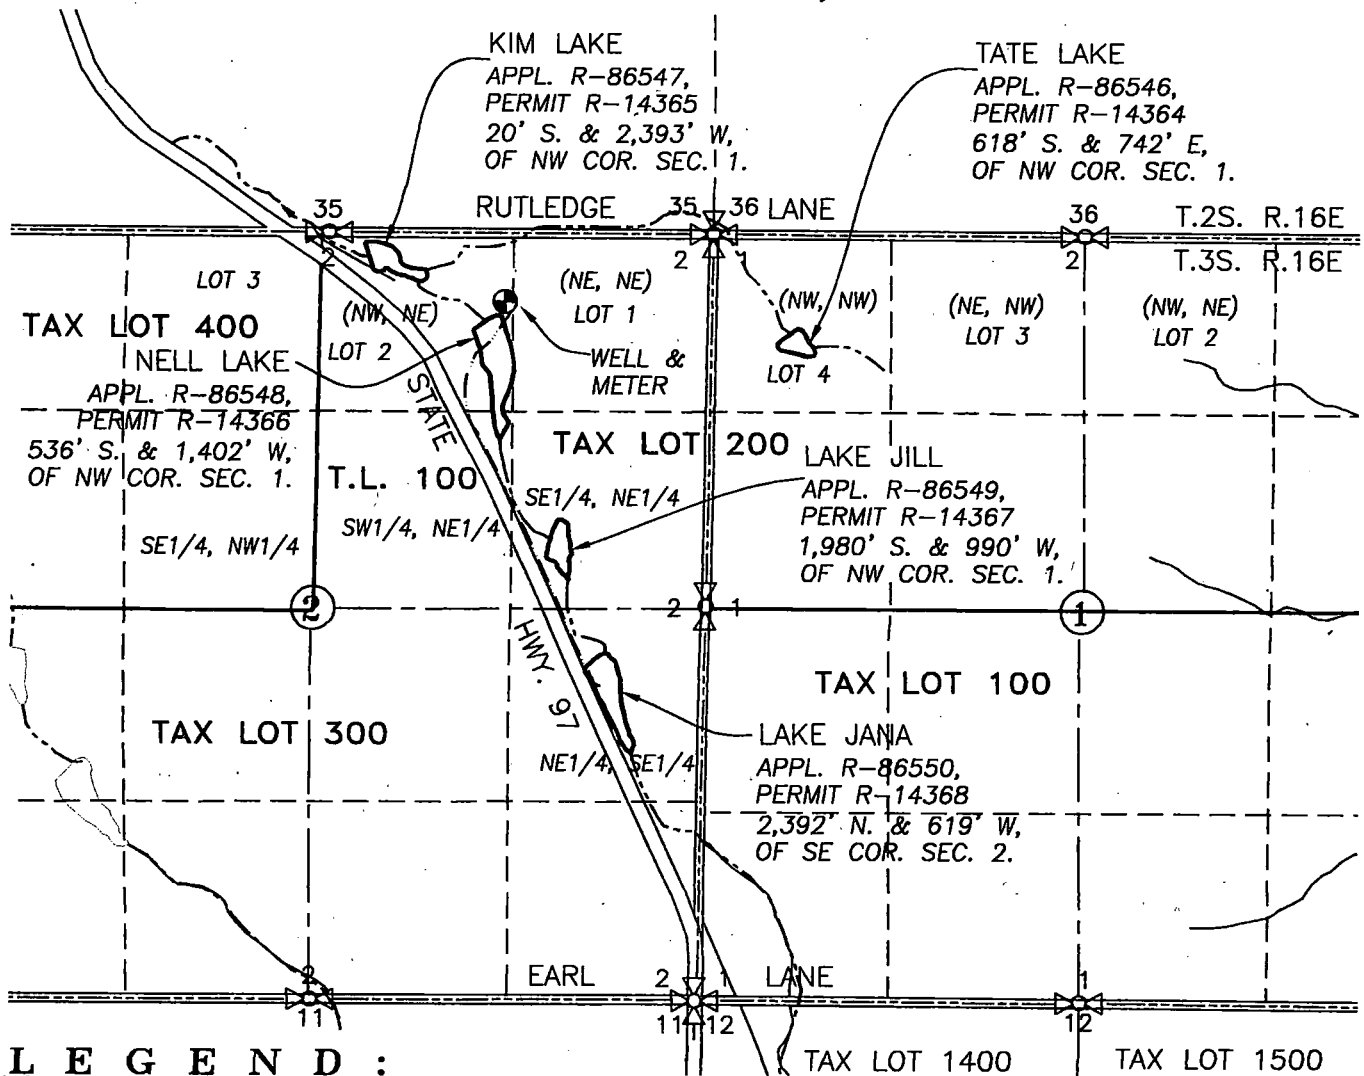


LEGEND:

- RESERVOIR (LAKE)
- STREAM WITH DIRECTIONAL FLOW
- WELL LOCATION 472' SOUTH AND 1430' WEST OF NE CORNER, SECTION 2
- 3" PVC PIPELINE

CLAIM OF BENEFICIAL USE MAP

0' 660' 1320' 2640'

SCALE: 1"=1320'

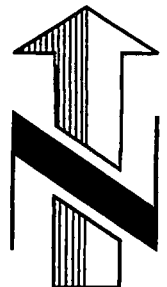

APPLICATION No. G-16658

PERMIT No. G-16192

IN THE NAME OF:

BUCK HOLLOW RANCH, INC.

DATE: MARCH 20, 2024

BY: **TENNESON ENGINEERING CORP.**

3775 CRATES WAY
THE DALLES, OREGON. 97058
PH. 541-296-9177
FAX 541-296-6657



Received
APR 29 2024
Received
MAY 08 2024
OWRD



EXPIRES: 12/31/2025

NOTE:

"THIS MAP IS NOT INTENDED TO PROVIDE
LEGAL DIMENSIONS OR LOCATIONS OF
PROPERTY OWNERSHIP LINES."

TEC W.O. #12025

AKS W.O. #10837