

CLAIM OF BENEFICIAL USE

Application No. R-72333
Permit No. R-11862
Tax Lot No. 10 40 4100
Baker County



Application No. R-72334
Permit No. R-11863
Tax Lot No. 10 40 6100, 6200 & 6500
Baker County

Applicant:

Eugene M. & Joan E. Davilla
HCR 87, Box 576
Baker City, OR 97814



Scale: 1" = 2,000'

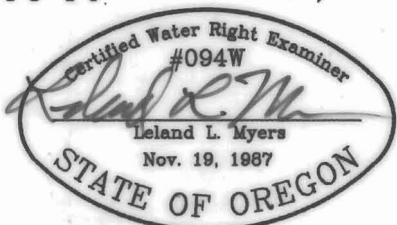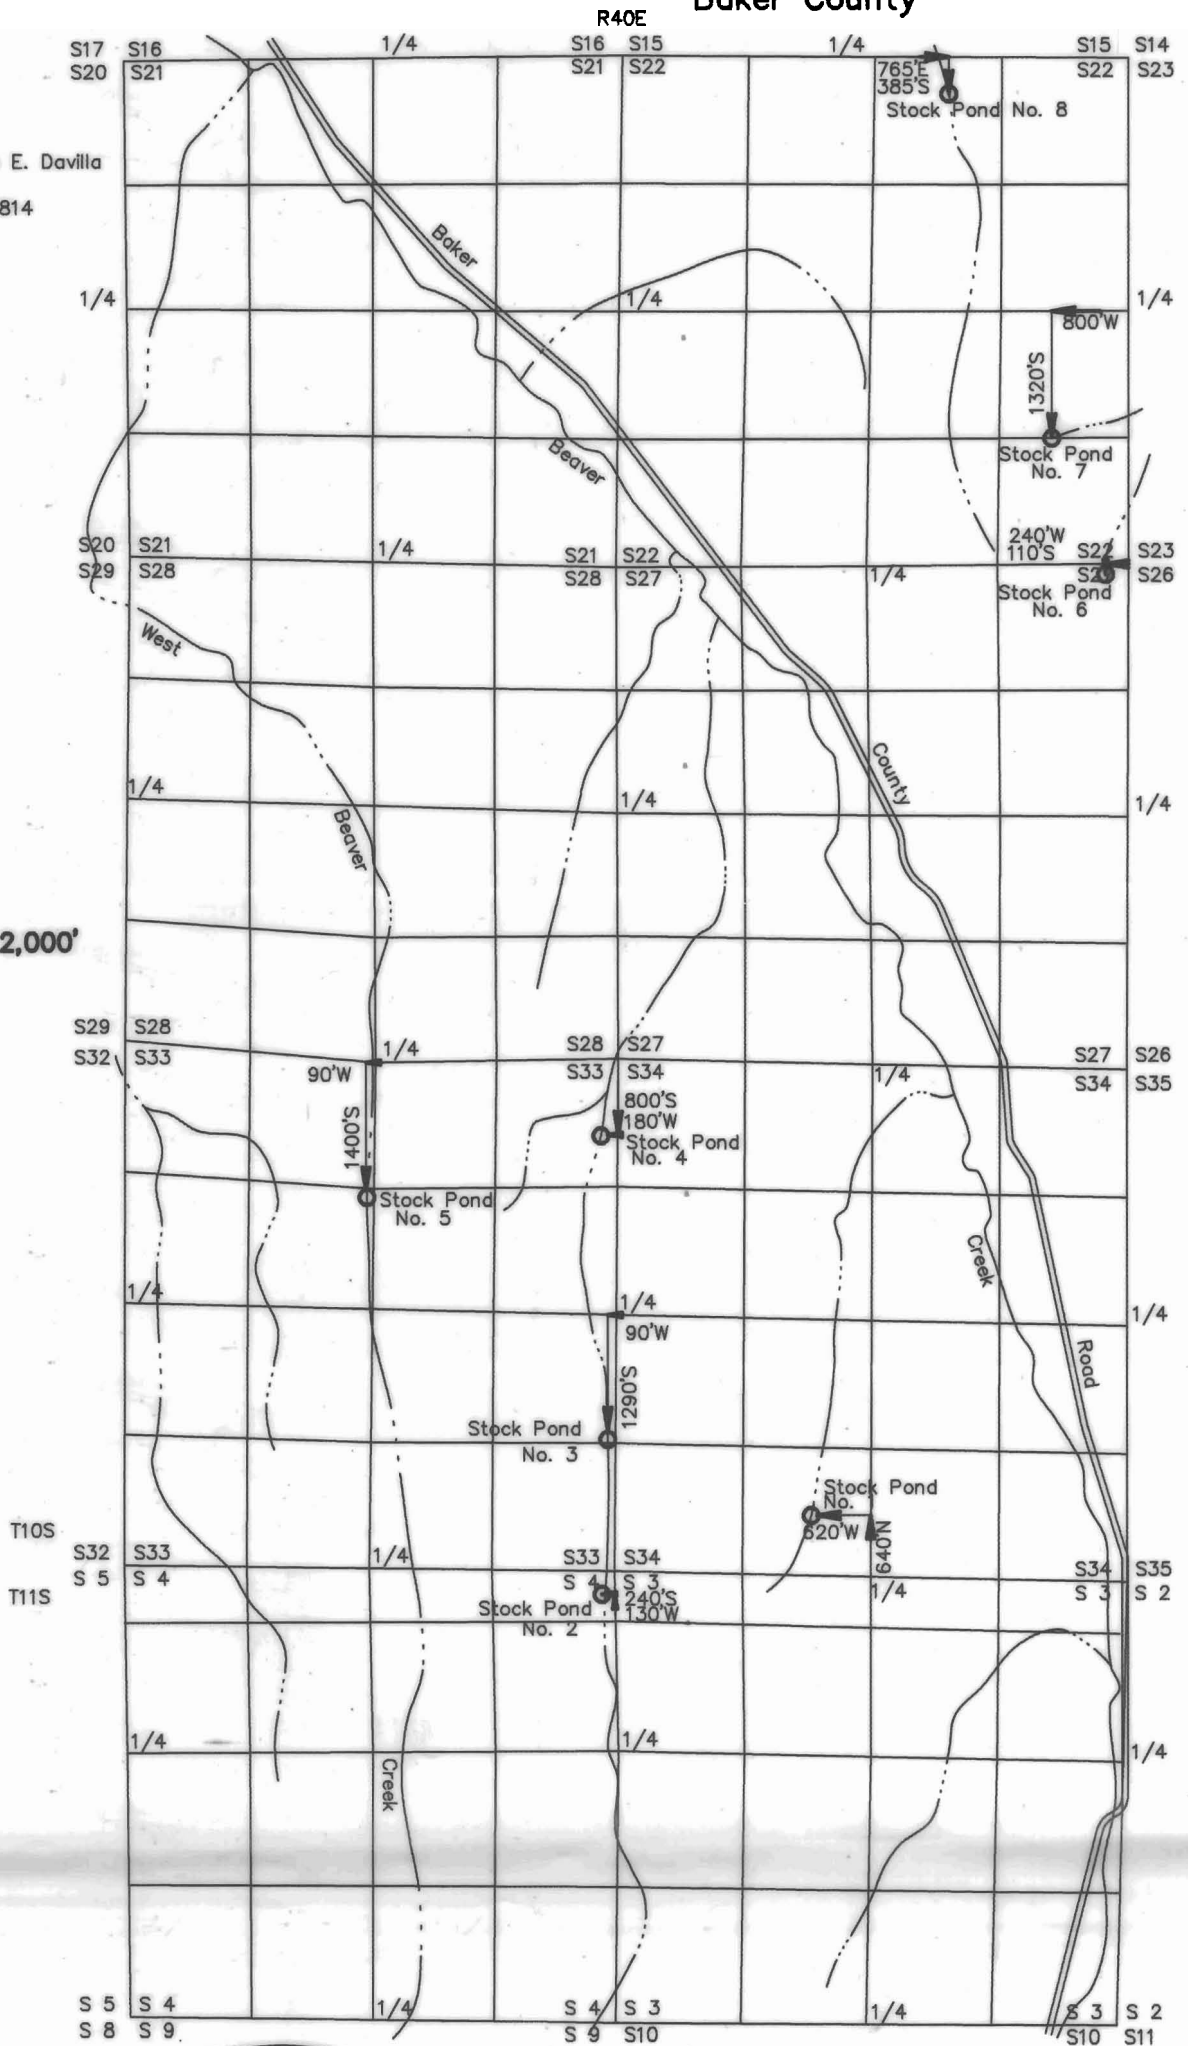

This map is for the purpose of identifying the location of the water right only and has no intent to provide dimensions or location of property ownership lines.

SEP 29 2000

WATER RESOURCES DEPT.
SALEM, OREGON

CONSTRUCT RESERVOIR PERMIT APPLICATION MAP



RECEIVED
NOV 19 1987

Applicant:

Eugene M. & Joan E. Davilla
HCR #87, Box 576
Baker City, OR 97814

Scale: 1" = 2,000'

Application No. R-72334
Permit No. R11863

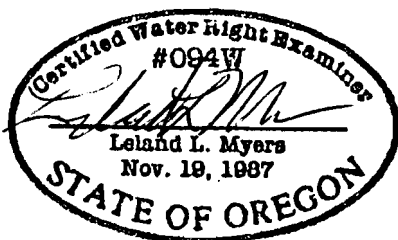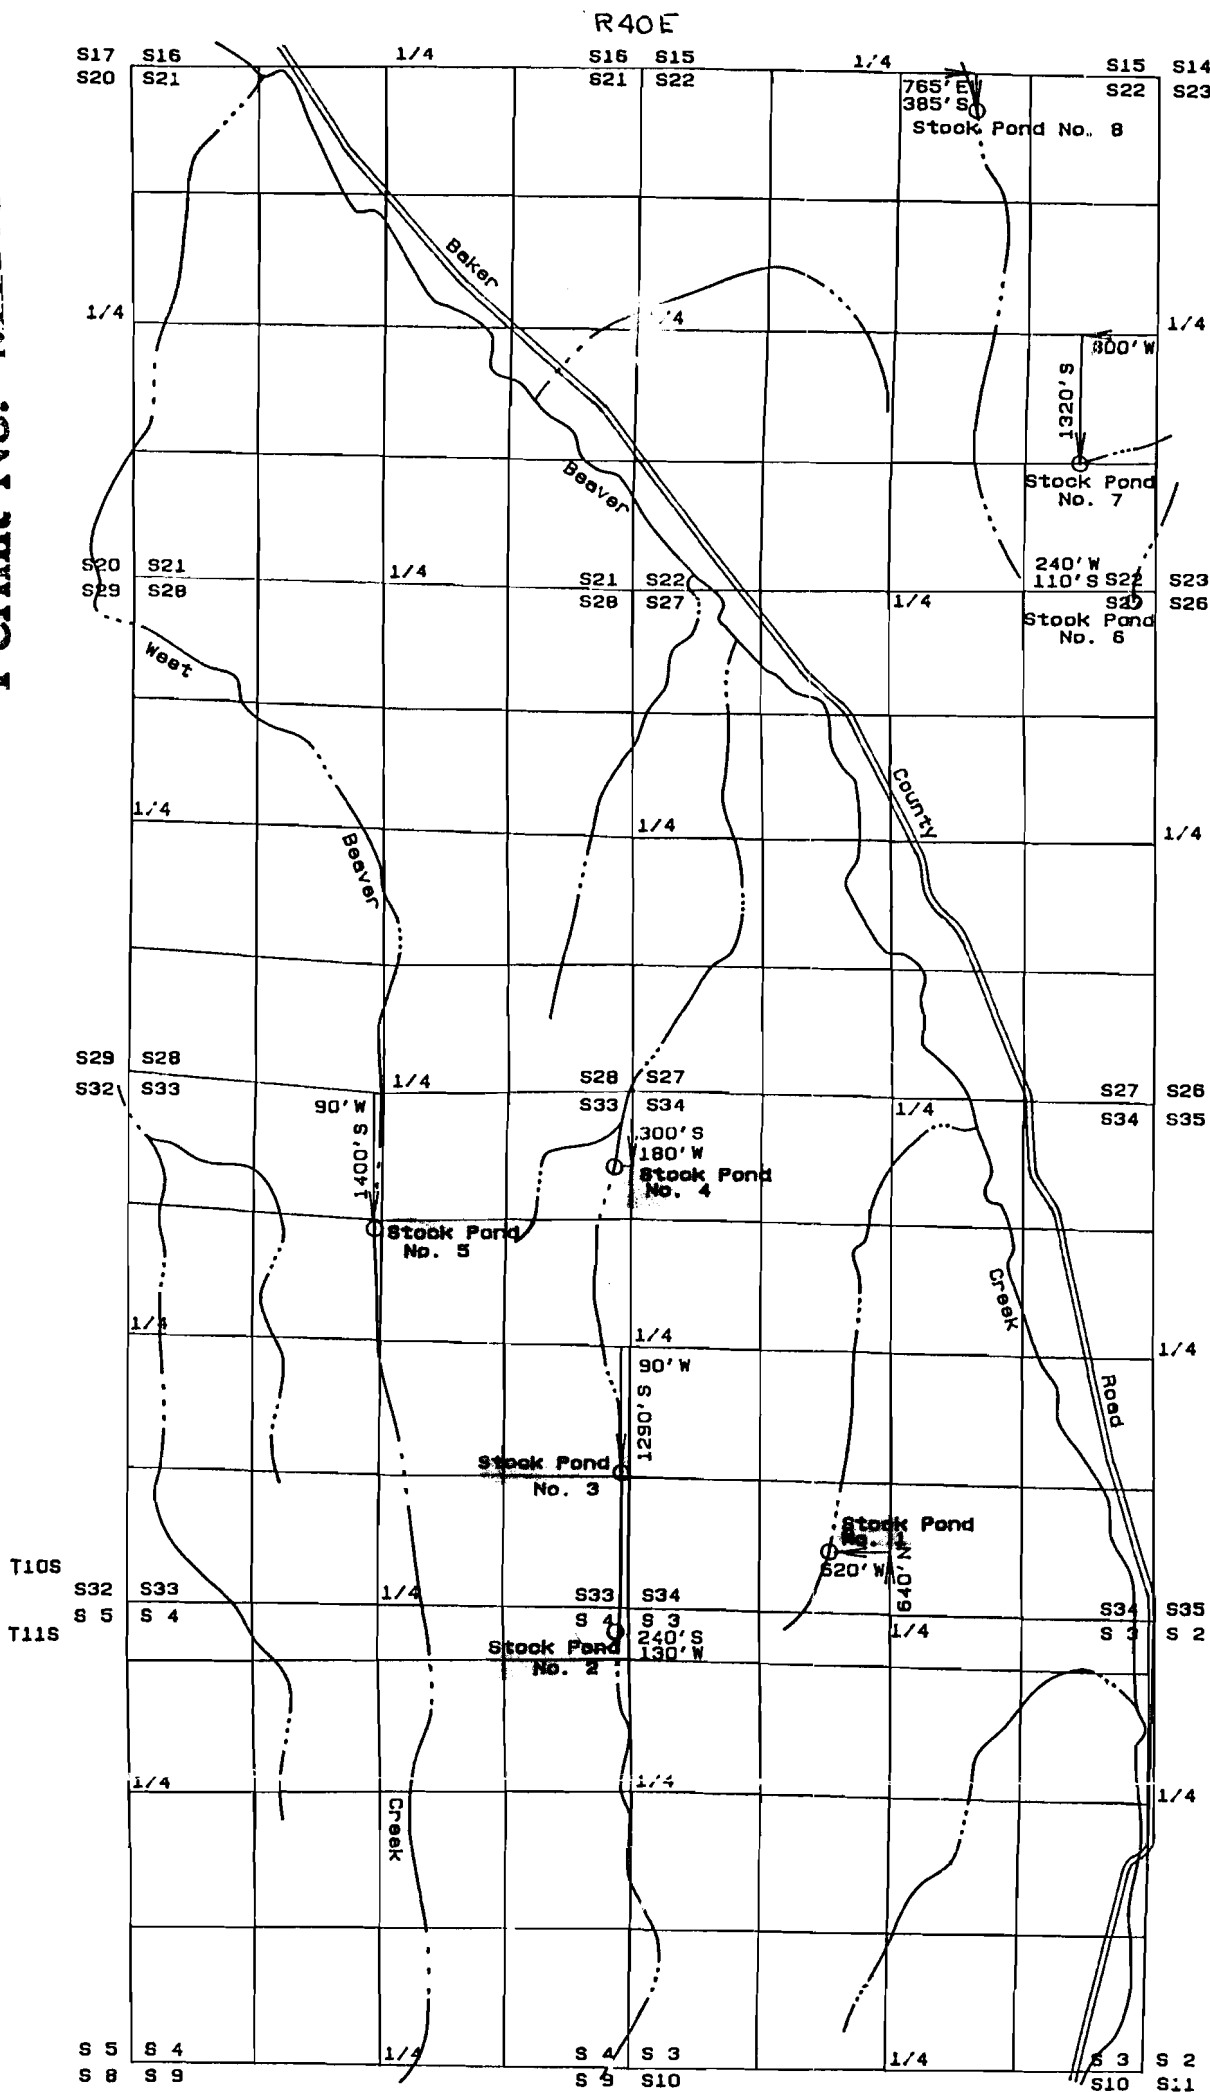

This map is for the purpose of identifying the location of the water right only and has no intent to provide dimensions or location of property ownership lines.