


Todd Arnoldus Groundwater Application Map
Township 1 South, Range 38 East, WM

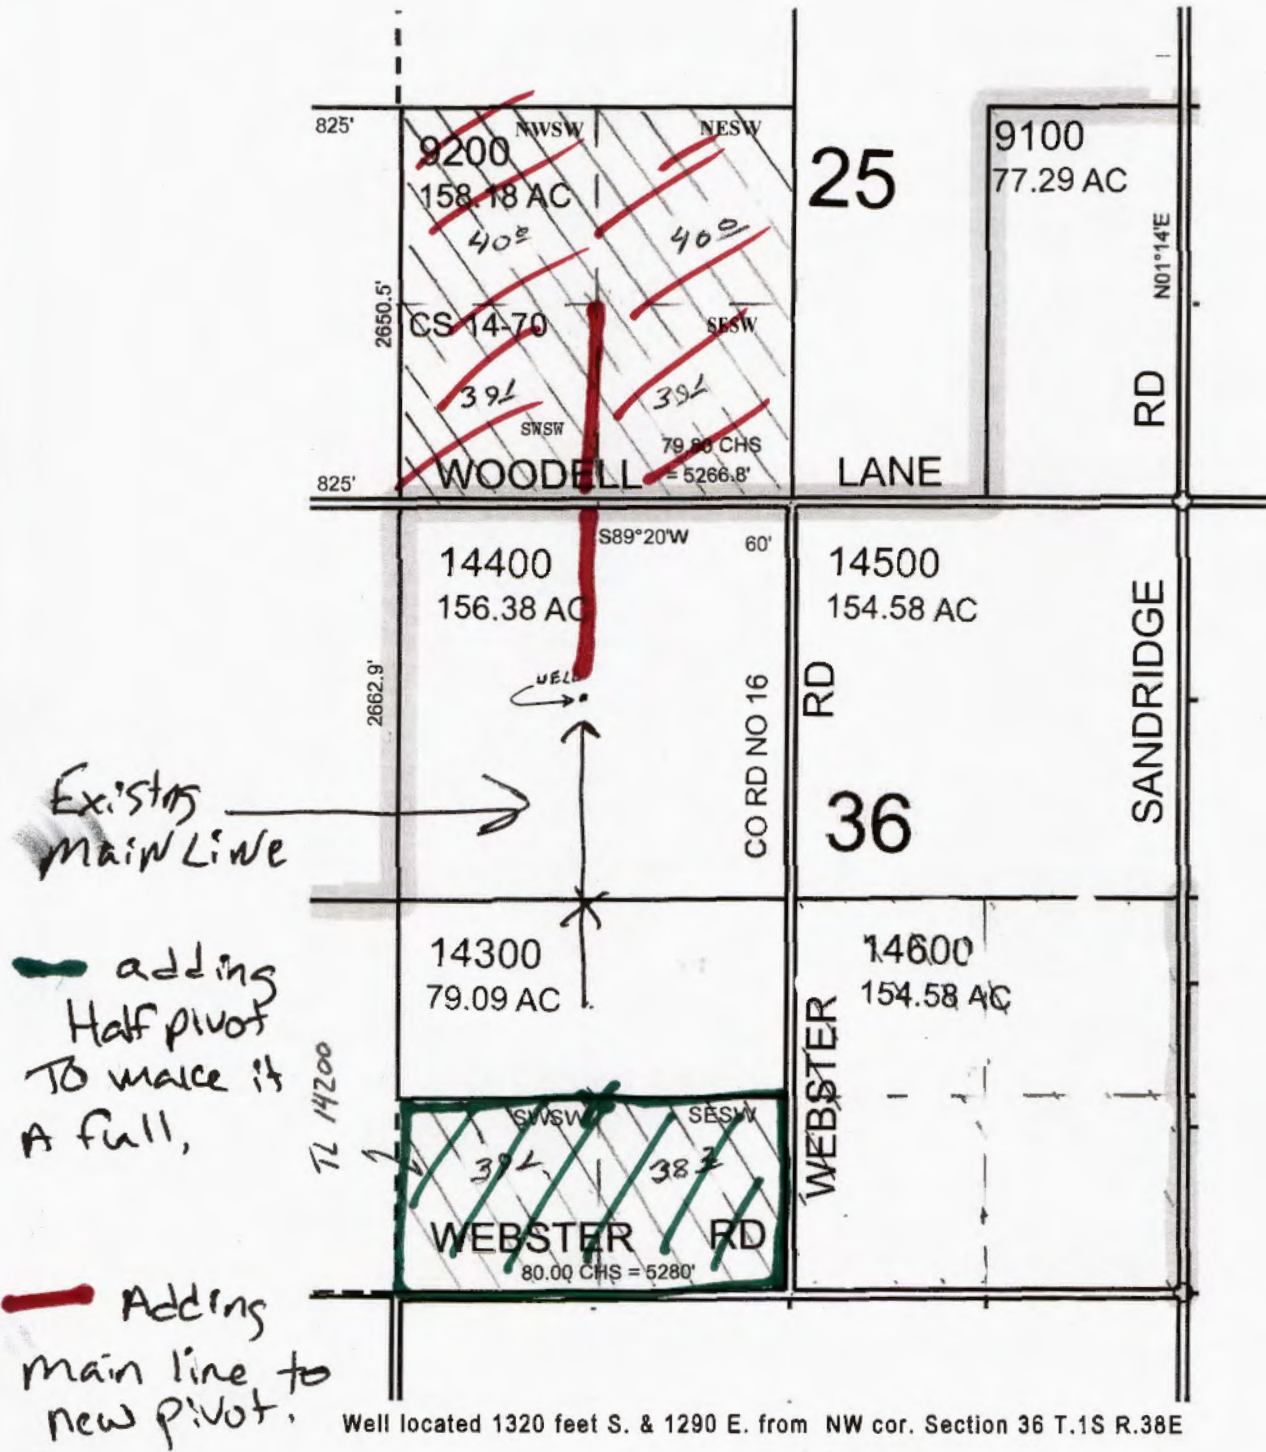

Scale 1"=1320'

Received
MAY 16 2024
OWRD

