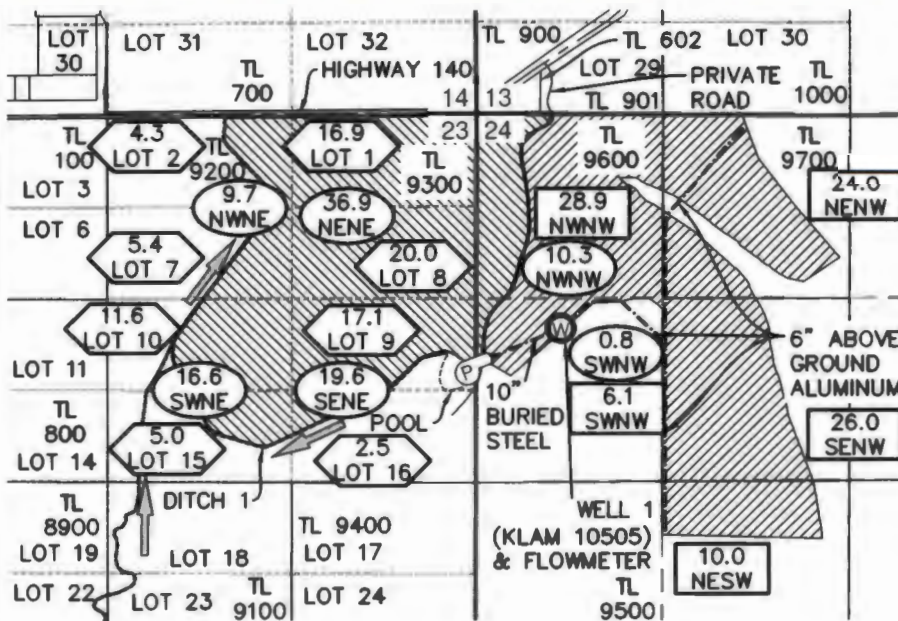


NOTES:

1. THIS MAP WAS PREPARED FROM FIELD MEASUREMENTS, NAIP 2023 AERIAL PHOTOGRAPHY, KLAMATH COUNTY TAX MAPS, AND OREGON GLO MAPS.

2. THE PURPOSE OF THIS MAP IS TO IDENTIFY THE LOCATION OF THE WATER RIGHT ONLY, AND IS NOT INTENDED TO PROVIDE DIMENSIONS OR LOCATION OF PROPERTY LINES.

3. DATE OF PRIORITY FOR THIS WATER RIGHT IS AUGUST 26, 1993.


WELL LOCATION:

WELL 1 (KLAM 10505): 1562' SOUTH & 618' EAST FROM THE NORTHWEST CORNER OF SECTION 24.

Received by OWRD

MAY 20 2024

Salem, OR

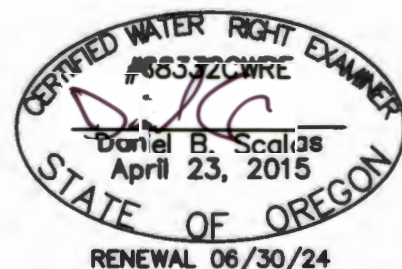

LEGEND

—	SECTION LINE	⊙	WELL
- - -	1/4 1/4 LINE	▨	IRRIGATED UNDER PERMIT G-12912 (SUPPLEMENTAL TO KA 119)
---	GOVERNMENT LOT LINE	▨	IRRIGATED UNDER PERMIT G-12912 (SUPPLEMENTAL TO CERTIFICATE 67800)
---	TAX LOT LINE	35.0 SWSE	IRRIGATED ACRES (SUPPLEMENTAL TO KA 119)
---	DITCH LINE	4.9 LOT 2	1/4 1/4 SECTION
---	MAINLINE PIPE	35.0 SWSE	IRRIGATED ACRES (SUPPLEMENTAL TO CERTIFICATE 67800)
---	ROAD	GOVERNMENT LOT NUMBER	
⊙	BOOSTER PUMP	IRRIGATED ACRES (SUPPLEMENTAL TO KA 119)	
←	FLOW DIRECTION	GOVERNMENT LOT NUMBER	
22/22	SECTION CORNER	POOL	
22/22			
TL 0000	TAX LOT NUMBER		
LOT 1	GOVERNMENT LOT NUMBER		
○	POOL		

AL ADKINS
ENGINEERING & SURVEYING

o / 541.684.4666
w / AdkinsEngineering.com

1435 ESPLANADE AVENUE, KLAMATH FALLS, OR 97601

SERVING S. OREGON & N. CALIFORNIA

CLAIM OF BENEFICIAL USE AND FINAL PROOF MAP

FOR
PATTON RANCH MANAGEMENT
T36S, R12E, SECS. 23 & 24, WM
KLAMATH COUNTY, OREGON
PERMIT G-12912
APPLICATION G-13503

5/16/2024

ENGINEERING • SURVEYING • PLANNING • TESTING

4107-01