


received
MAY 13 2024

Township 2 North Range 13 East Section 20
Tax Lots 400 and 500

OWRD

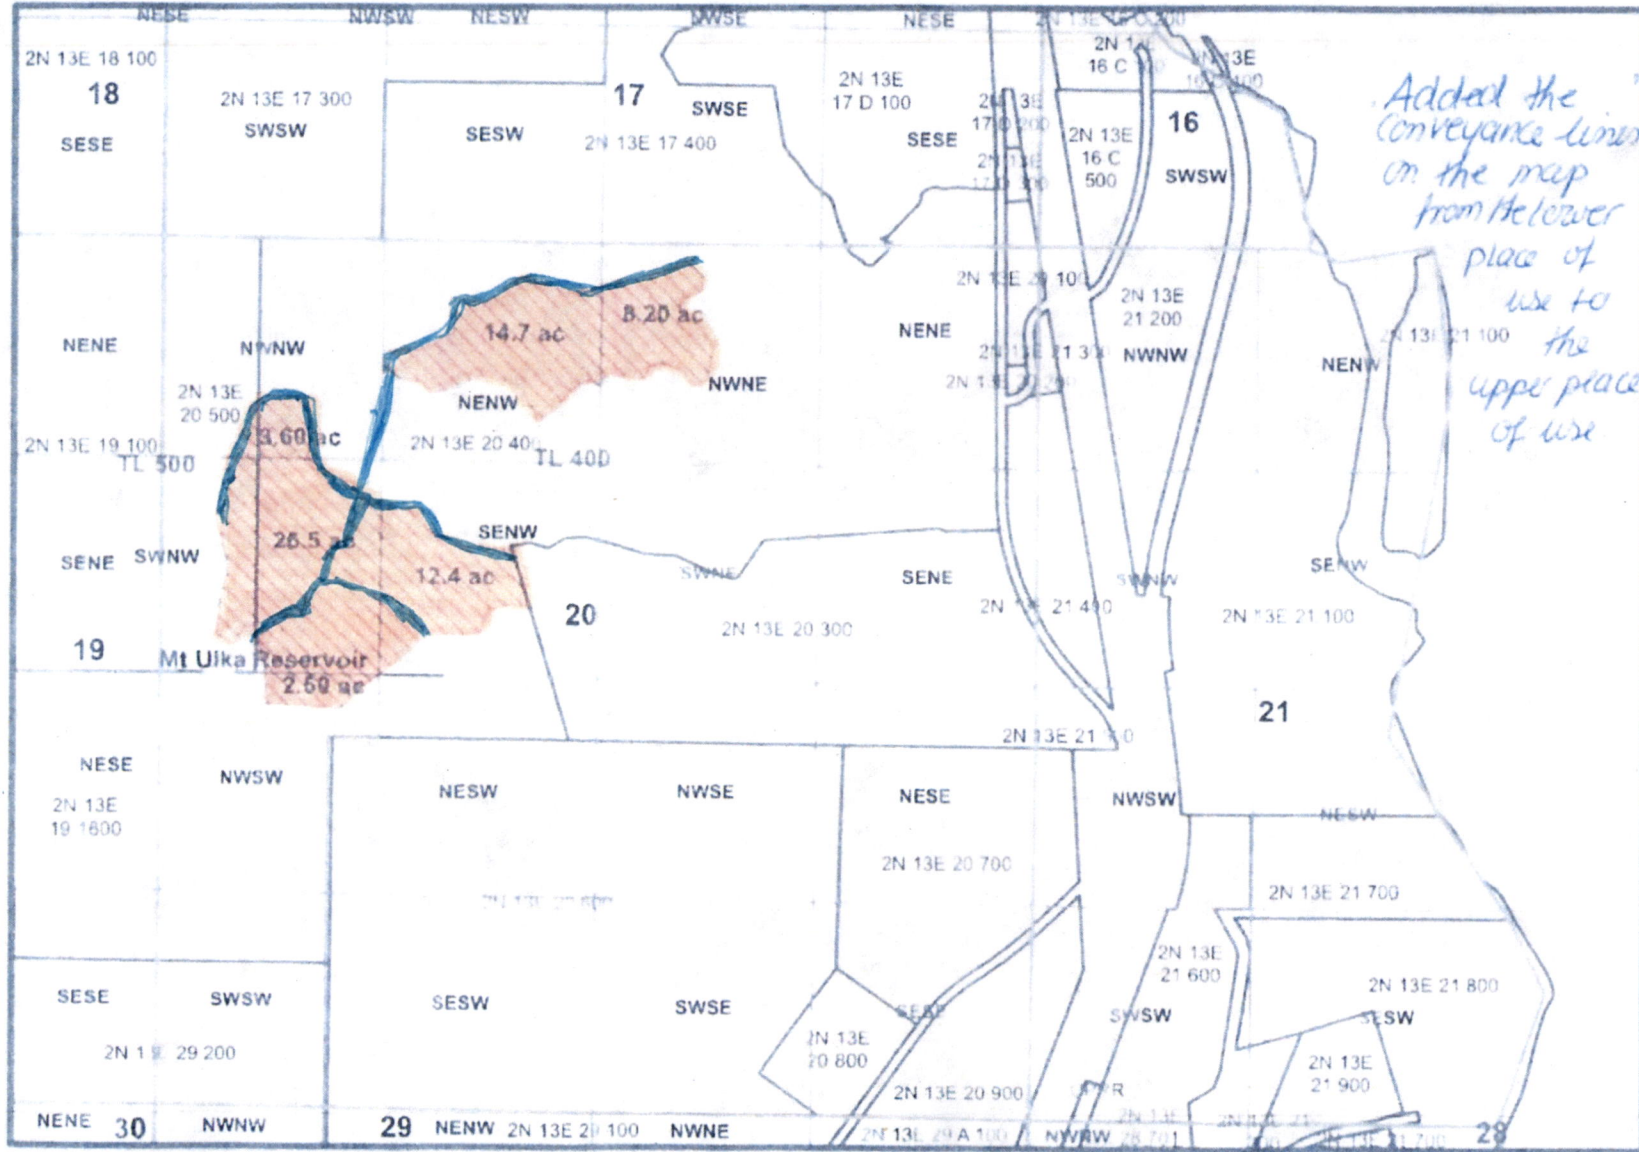

Dam is 2,464' South and 575' East from NW Corner, Section 20.



Received by OWRD

MAY 16 2024

Salem, OR