


FINAL PROOF MAP

UNDER
Application No. R-71727 Permit No. R-11816

IN THE NAME OF: Robert & Caroline Estill
1211 Plantation Meadows Dr.
Richmond, Texas 77469

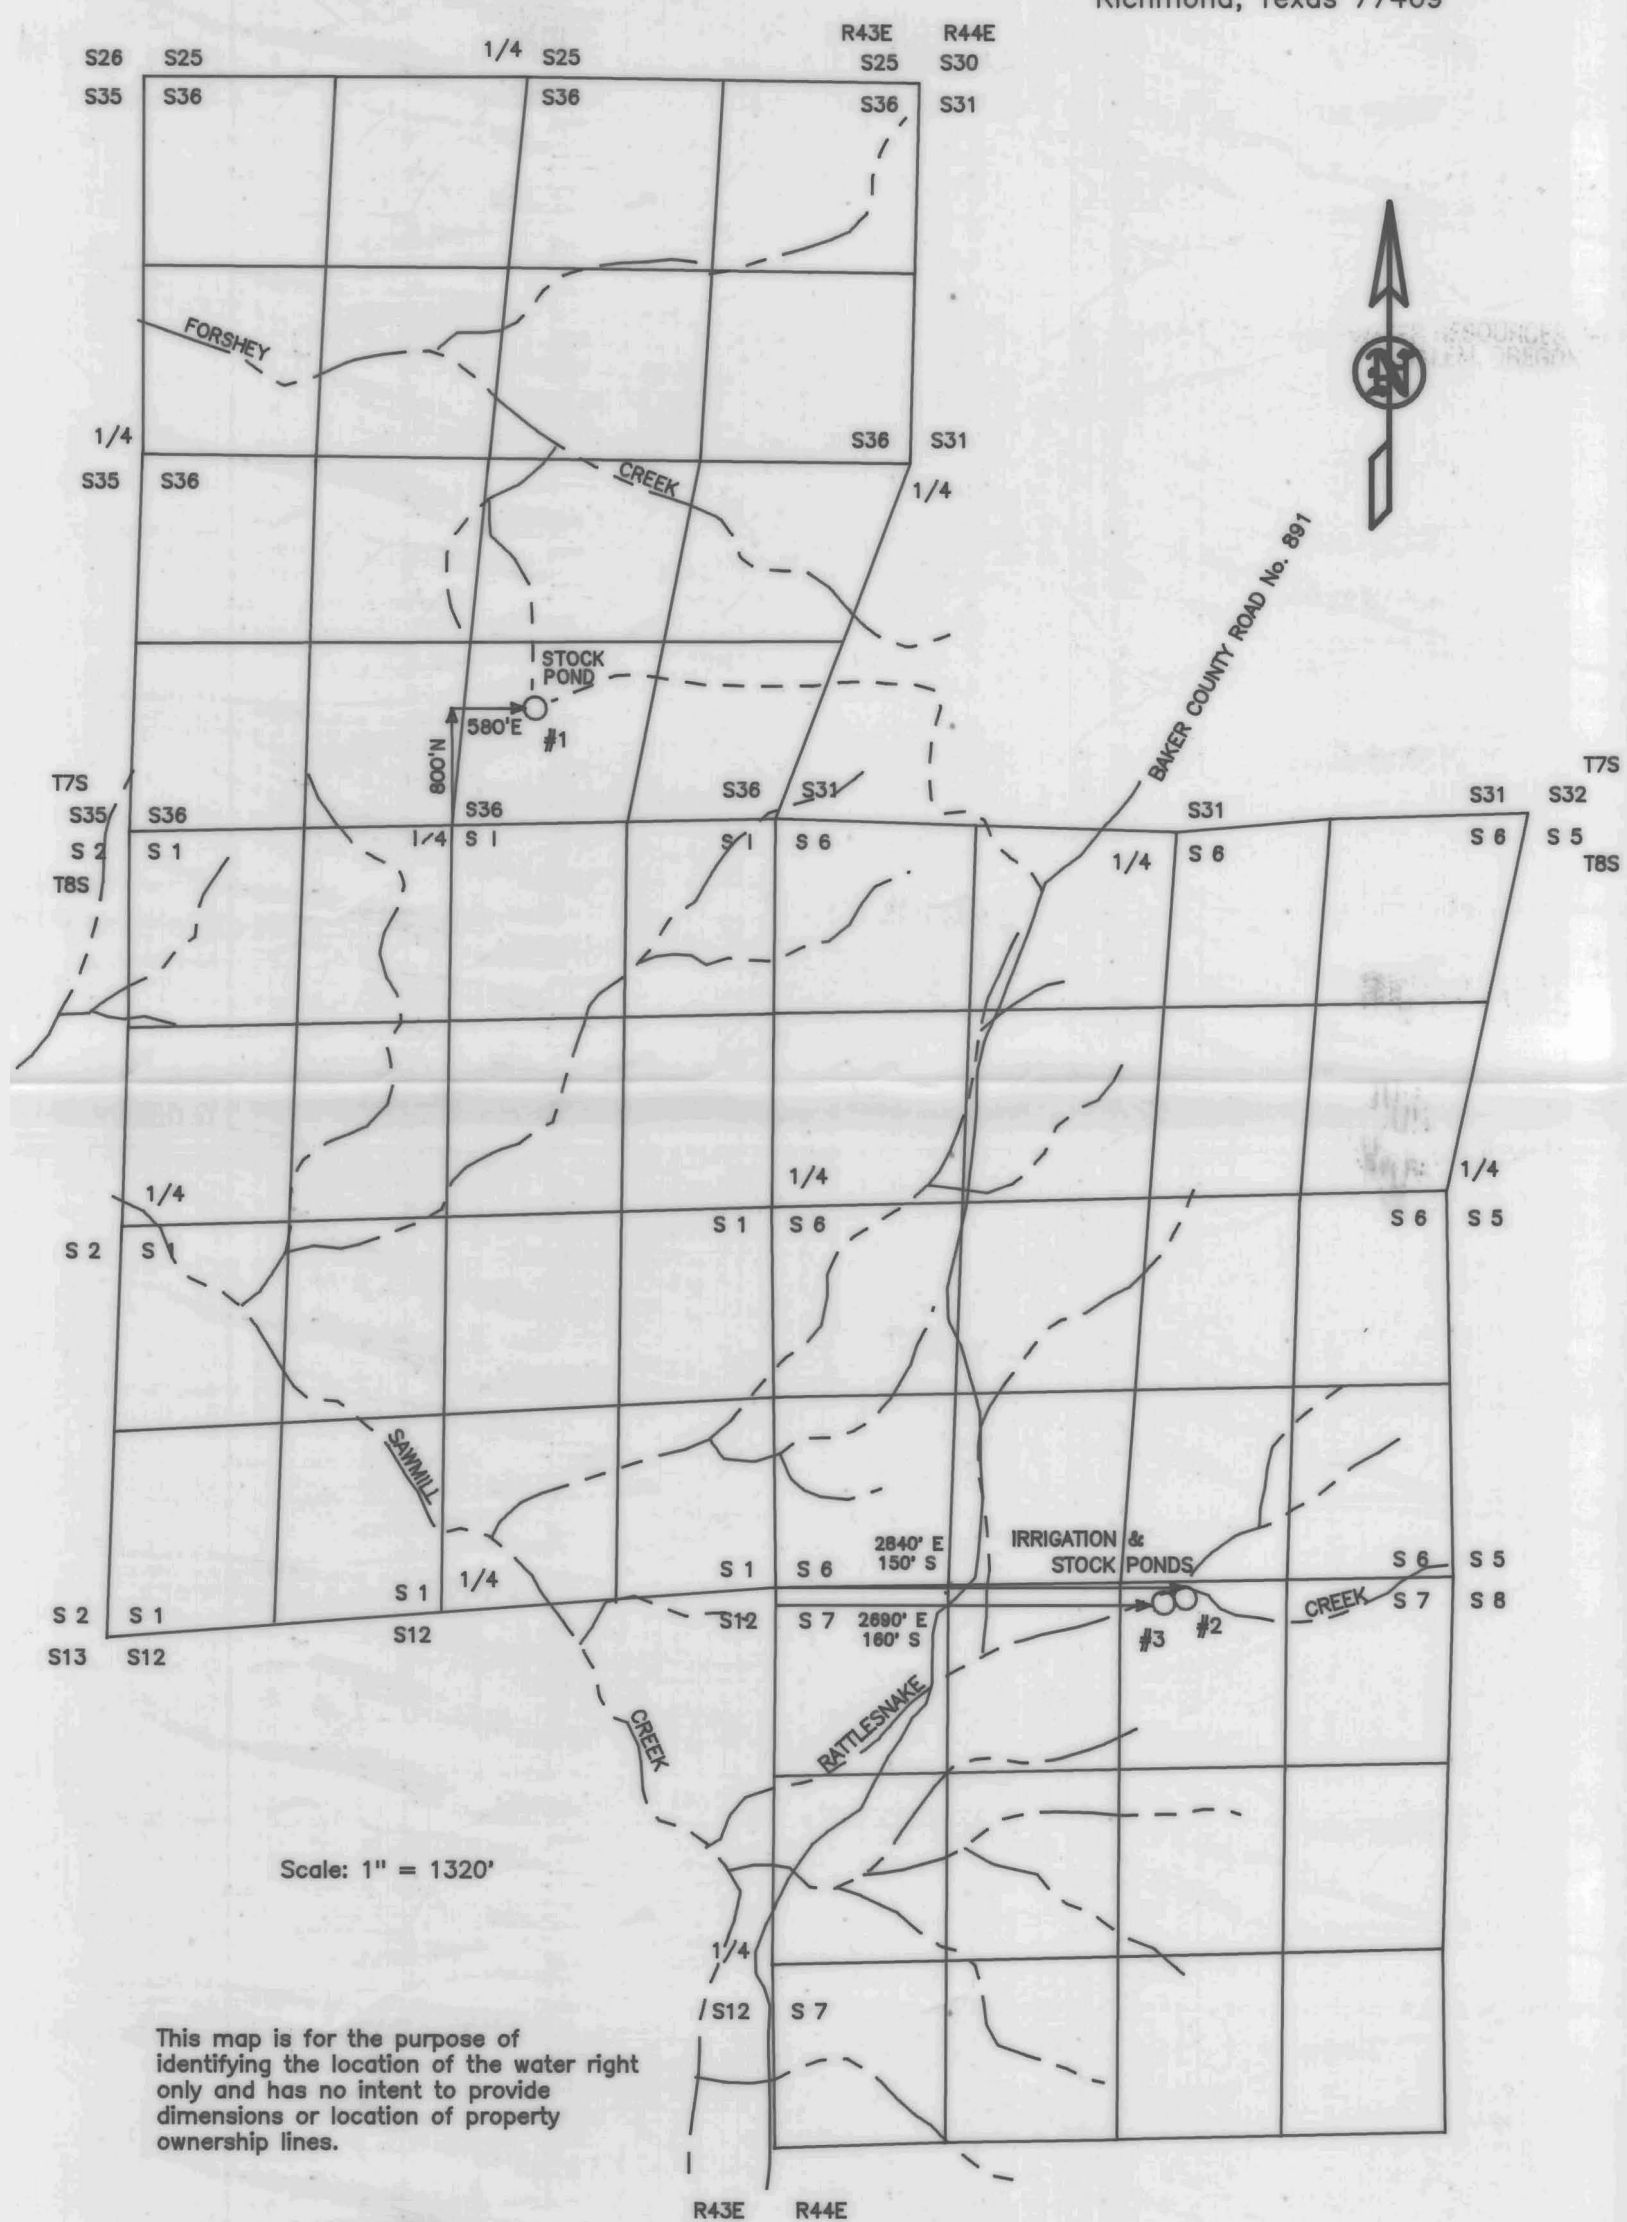

Certified Water Right Examiner
#094W
Leland L. Myers
Leland L. Myers
Nov. 19, 1987
STATE OF OREGON