




T18S R5W, WM LANE COUNTY, OR

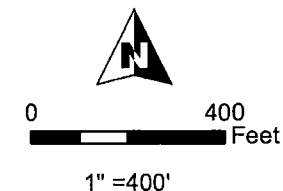

- POD & Fishscreen - Creek
- ⊙ POD - Pond
- Storage Tank / Meter
- Creek
- Pipeline
- Section
- Quarter Quarter
- Tax Lot
- ▨ POU R-15388 (Lifted Pond)
- ▨ POU IR S-55319

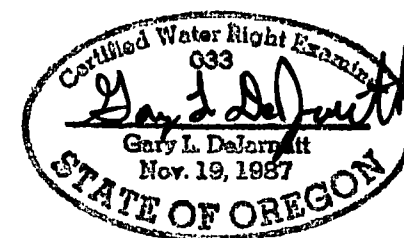

RENEWAL DATE 12/31/2023

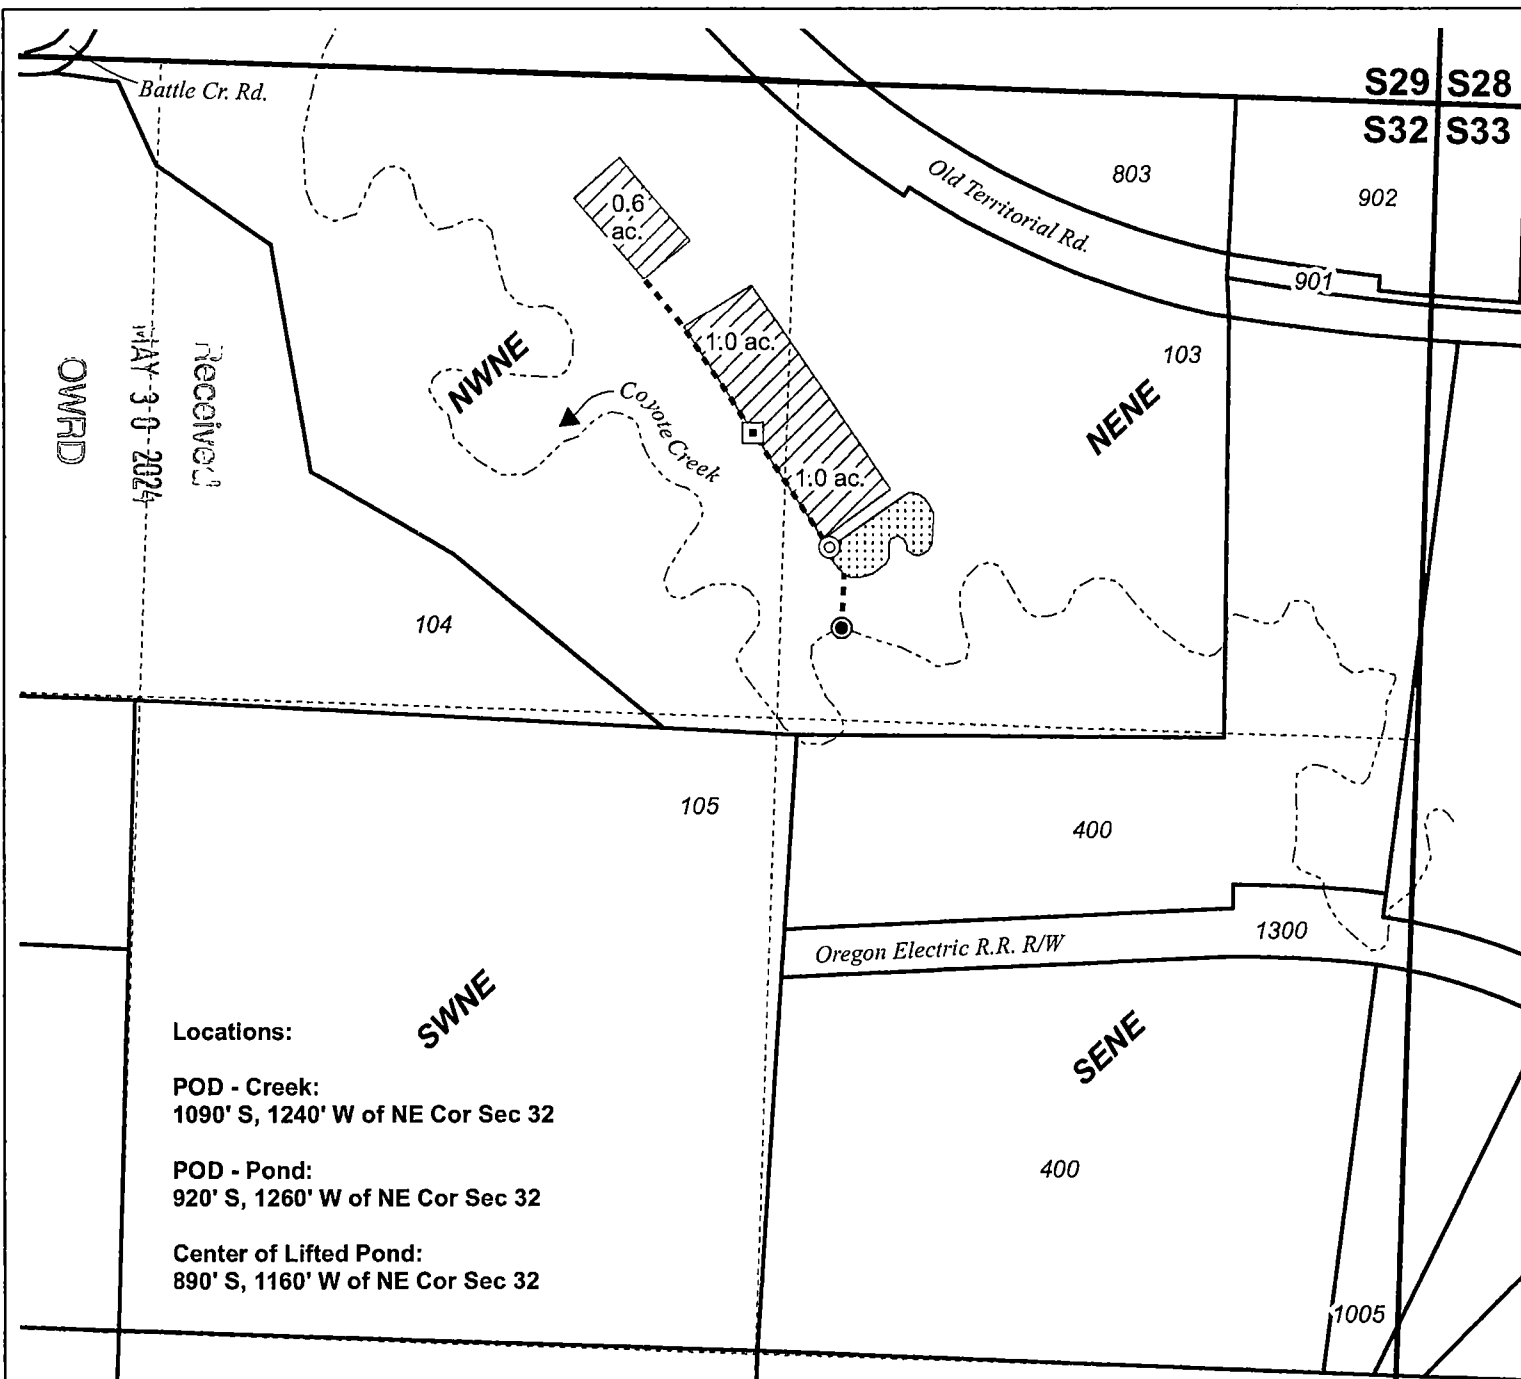

Locations:

POD - Creek:
1090' S, 1240' W of NE Cor Sec 32

POD - Pond:
920' S, 1260' W of NE Cor Sec 32

Center of Lifted Pond:
890' S, 1160' W of NE Cor Sec 32

CLAIM OF BENEFICIAL USE MAP JRAW FARM, LLC

Date: 9/29/2023

Ap R-88699/Permit R-15388 / #23033
Ap S-89104/Permit S-55319 / #23049

This map is not intended
to provide legal dimensions
or locations of property
ownership lines.

WATER RIGHT SERVICES, LLC
PO BOX 1830, BEND, OR 97709
WWW.OREGONWATER.US CCB # 197121
johnshort@usa.com 541-389-2837