


Groundwater Application

Echols

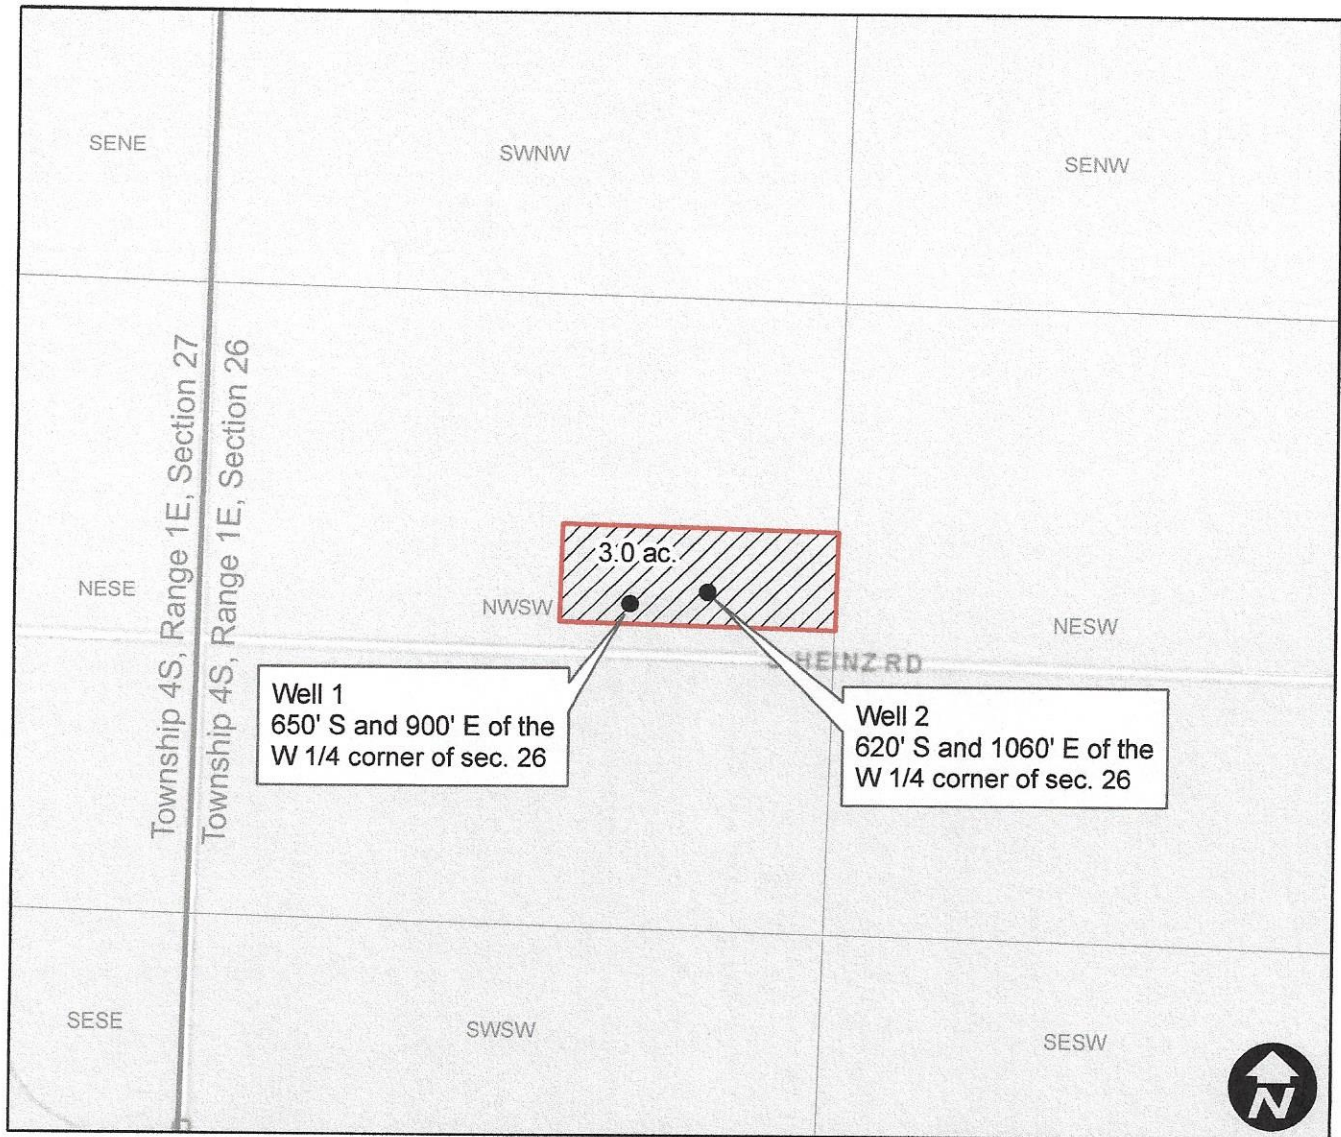

Legend

-  Proposed POU
-  Tax Lot 501

0 200 400 800 Feet

E-RECEIVED

December 4, 2020

OWRD

