


SECTION 3, T.13S., R.27E., W.M.
CLAIM OF BENEFICIAL USE MAP
UNDER T-13796
 FOR
DRISCOLL FAMILY TRUST

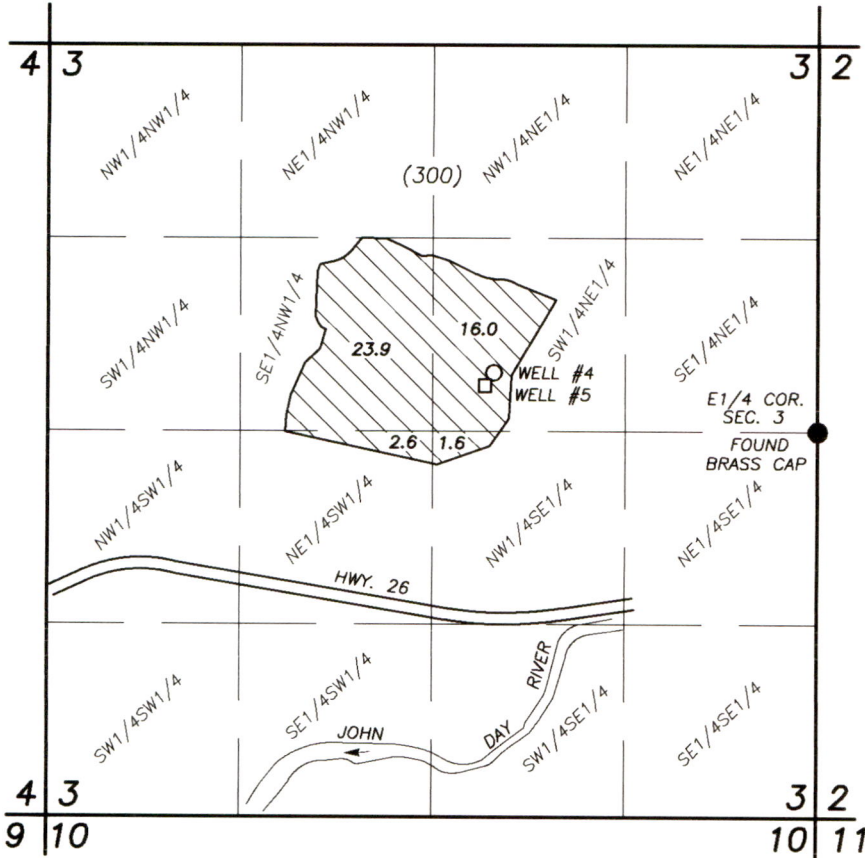

SCALE: 1" = 1320'

○ AUTHORIZED POA: WELL #4: 400' NORTH & 2220' WEST OF E1/4 COR. SEC. 3


□ APOA: WELL #5: 380' NORTH & 2230' WEST OF E1/4 COR. SEC. 3
 FLOW METER BEARS NORTH, 2 FT.

PRIMARY USE PRIORITY DATE 1991

() TAX LOT NO.

PREPARED BY:
 ROBERT D. BAGETT, PLS, CWRE
 217 N. CANYON BLVD.
 JOHN DAY, OREGON
 (541) 620-0717
 (541) 575-1251
 MAY 10, 2024

Received
 MAY 31 2024
 OWRD

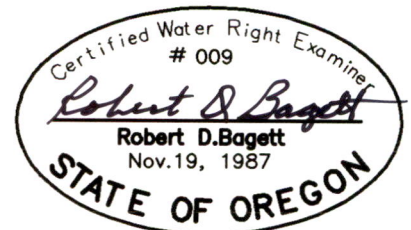

DISCLAIMER: THIS MAP IS NOT INTENDED TO PROVIDE LEGAL DIMENSIONS OR LOCATIONS OF PROPERTY OWNERSHIP LINES.

RENEWS 12/31/2025