


MAY 31 2024

Salem, OR

Claim of Beneficial Use - Lookout Point LLC (Nelson)

Application G-18310, Permit G-17770

Township 19S, Range 1W, W.M.

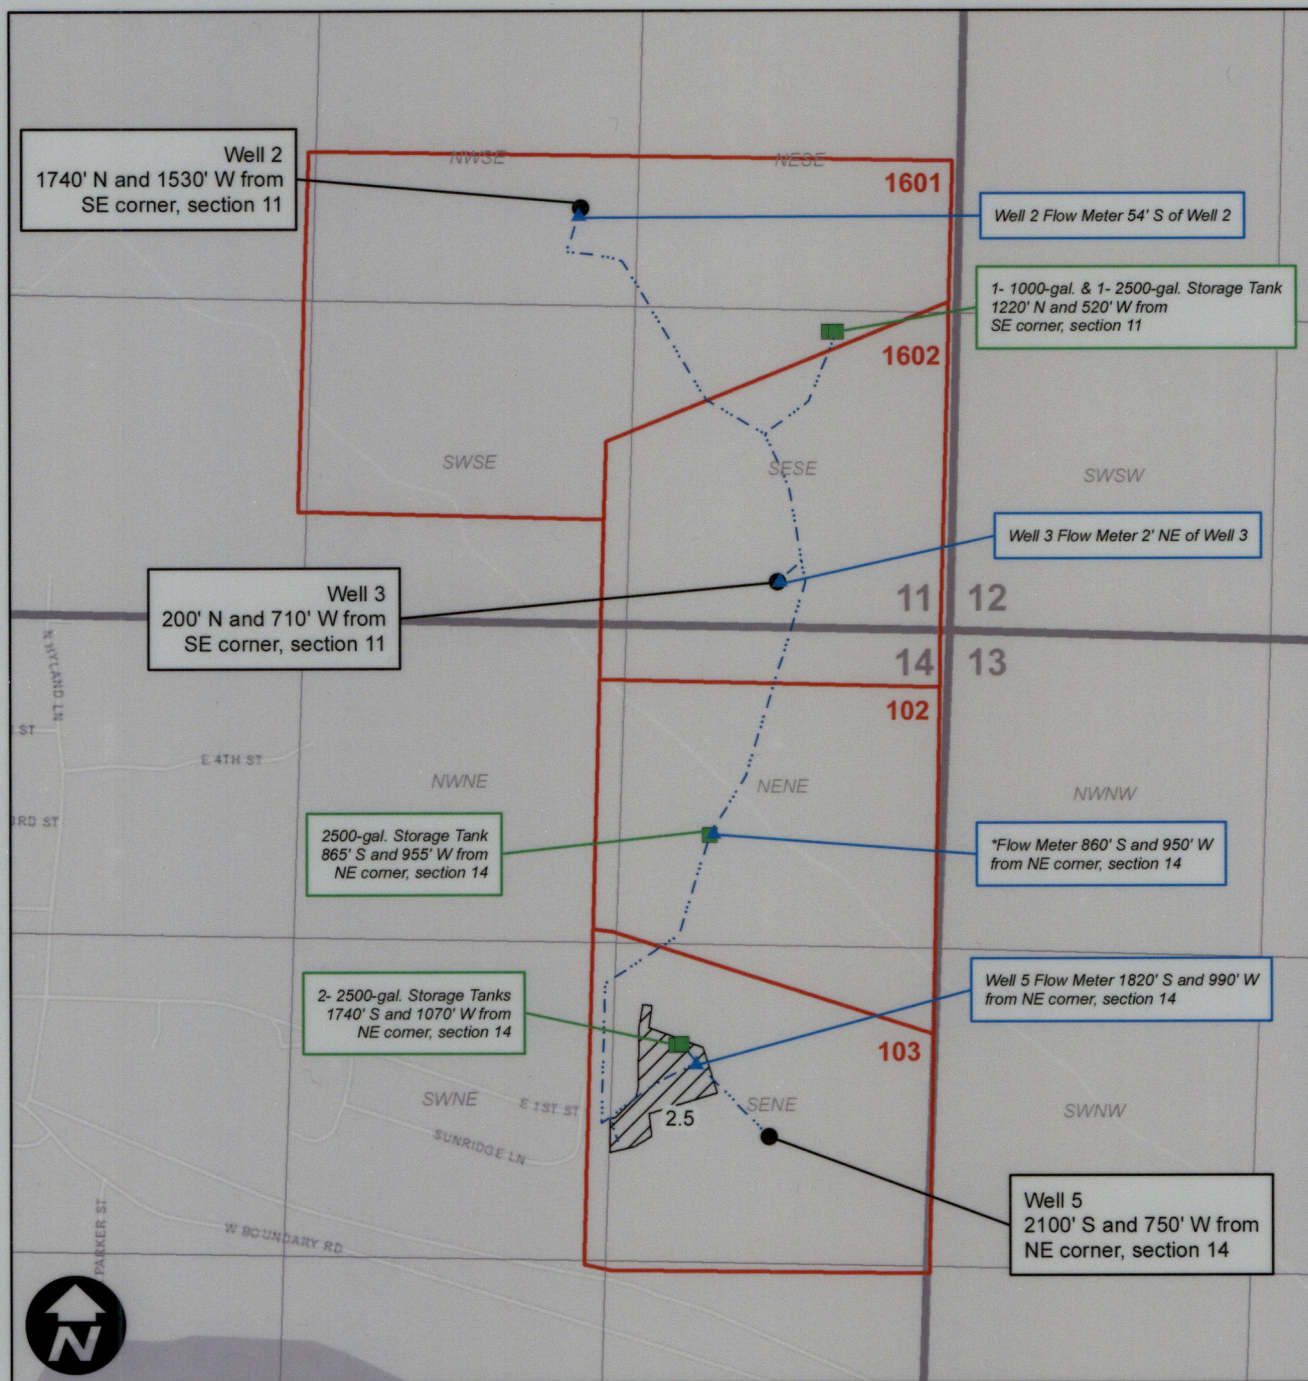

Legend

- Nursery POU
- Storage Tanks
- Mainline
- Flow Meters
- Wells
- Taxlots



EXPIRES: 12-31-2024