


Map For Claim of Beneficial Use

Section 30, T1S, R3W, Washington County
Transfer T-13916



1 IN = 400 FT
0 200 400

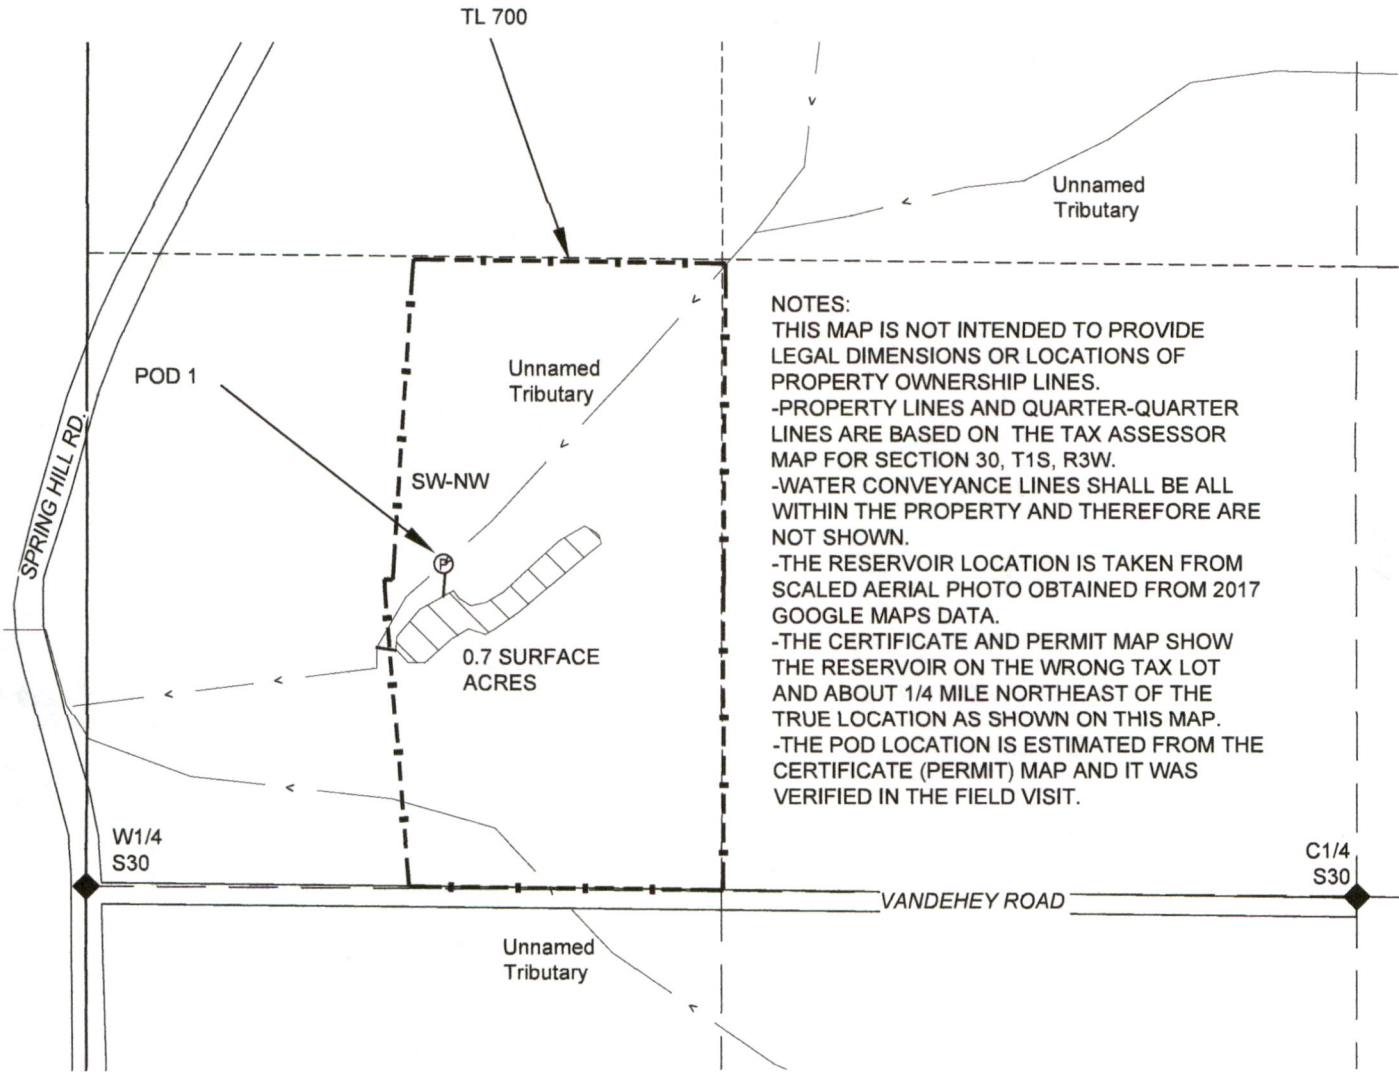

NOTES:
THIS MAP IS NOT INTENDED TO PROVIDE LEGAL DIMENSIONS OR LOCATIONS OF PROPERTY OWNERSHIP LINES.
-PROPERTY LINES AND QUARTER-QUARTER LINES ARE BASED ON THE TAX ASSESSOR MAP FOR SECTION 30, T1S, R3W.
-WATER CONVEYANCE LINES SHALL BE ALL WITHIN THE PROPERTY AND THEREFORE ARE NOT SHOWN.
-THE RESERVOIR LOCATION IS TAKEN FROM SCALED AERIAL PHOTO OBTAINED FROM 2017 GOOGLE MAPS DATA.
-THE CERTIFICATE AND PERMIT MAP SHOW THE RESERVOIR ON THE WRONG TAX LOT AND ABOUT 1/4 MILE NORTHEAST OF THE TRUE LOCATION AS SHOWN ON THIS MAP.
-THE POD LOCATION IS ESTIMATED FROM THE CERTIFICATE (PERMIT) MAP AND IT WAS VERIFIED IN THE FIELD VISIT.

POD1 IS 745' NORTH AND 670' EAST OF THE WEST 1/4 S30

Received
JUN 07 2024

OWRD

LEGEND

- DONATION LAND CLAIM CORNER (NONE)
- QUARTER CORNER
- POINT OF DIVERSION
- STREAM OR SURFACE DRAINAGE
- TAX LOT LINE
- SECTION LINE
- QUARTER-QUARTER LINE
- RESERVOIR



MAP BY:
ASPEN RURAL LAND CONSULTING
ERIC URSTADT, PE, PLS
971-250-1520
MAY 2024
Boyer2A