


SECTION 9, 10 & 16 T. 15., R. 3W., W. M.
WASHINGTON COUNTY, OREGON

CoBU Map for Application G 13028 Permit G 12137



EXPIRES: Dec. 31, 2025

SCALE: 1" = 400'

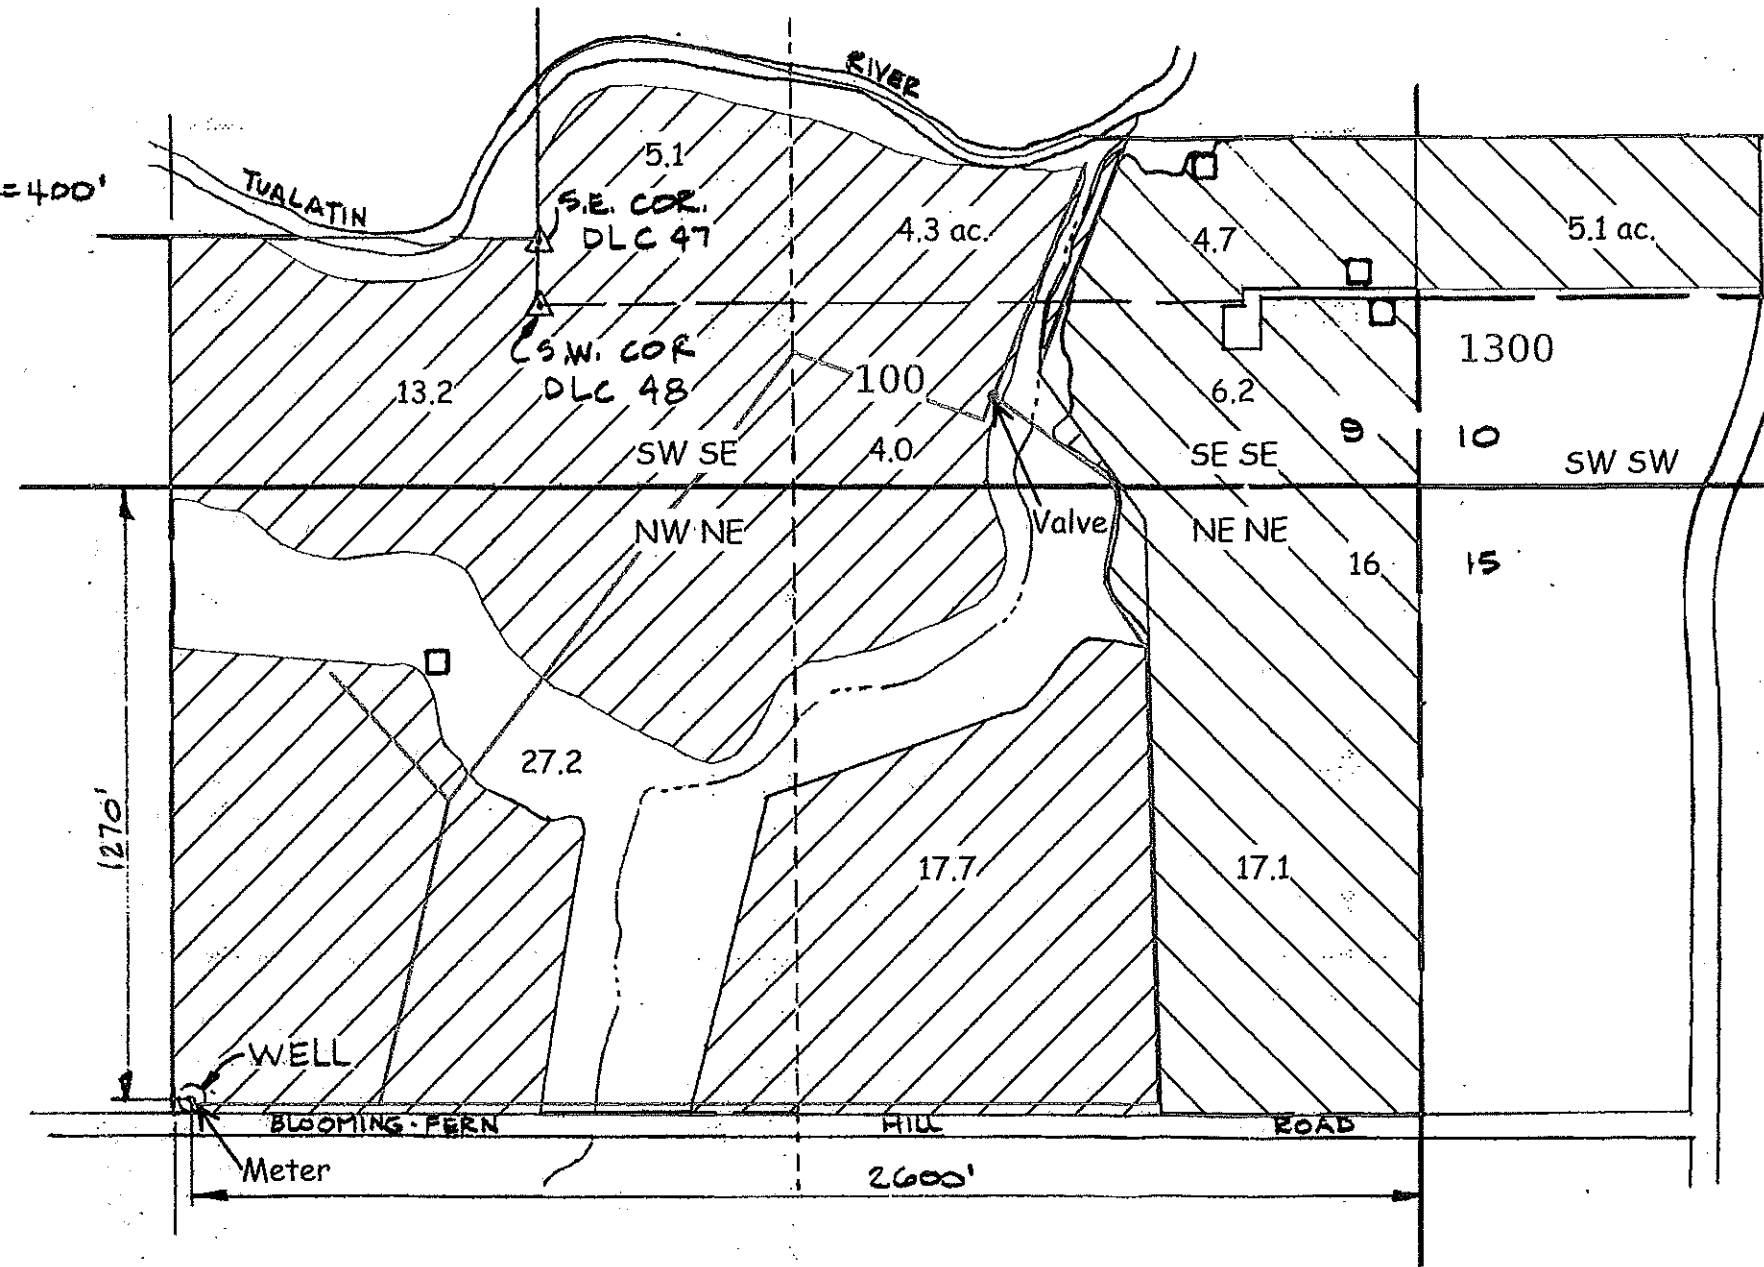

Legend

- Tax Lot boundary
- Main Line
- HOUSE
- ▨ Place of Use
- ▧ Not developed

REV 12.5.94

	by	date
designed	WRV	6.25.92
drawn	JEB	6.25.92
checked	WRV	6.25.92
drawing no.	92-B-06	
sheet no.	1/1	

Received by OWRD
JUN 12 2024
Salem, OR

VERBOORT ENGINEERING
AGRICULTURE • CIVIL • WATER RESOURCES
HILLSBORO, OREGON

DINSDALE FARM INC.
3839 SW GOLF COURSE ROAD
CORNELIUS, OR 97113

This map is not intended to provide legal dimensions or locations of property ownership lines

Map developed by Verboort Engineering for water right application and amended/modified by BK Water Right Consulting LLC for CoBU map.