


RECEIVED



SEP 23 1999

WATER RESOURCES DEPT
SALEM, OREGON
Lot 4

T13S R3W, WM

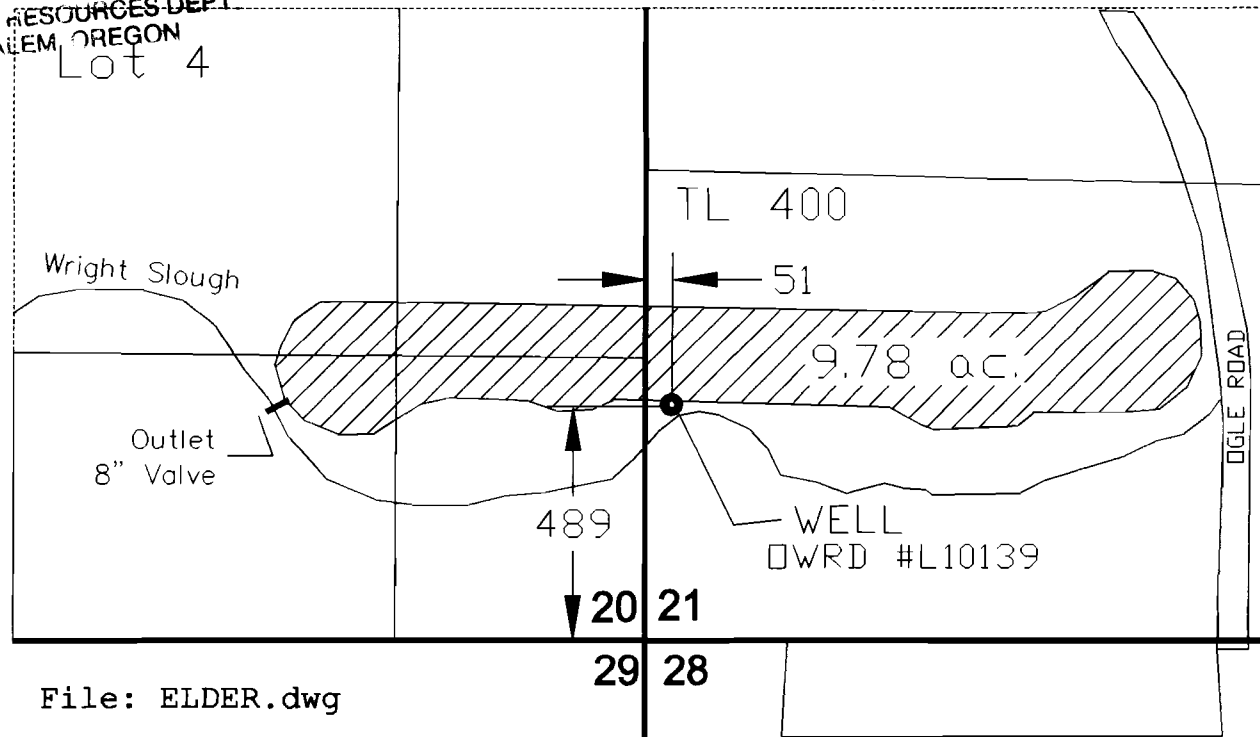

File: ELDER.dwg

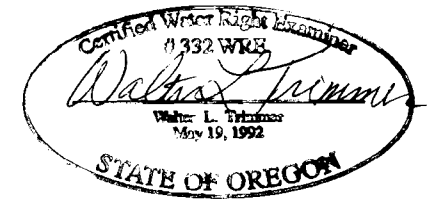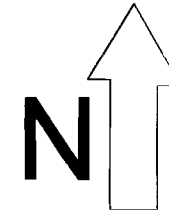

JUN 30 2000

FINAL PROOF SURVEY
UNDER

Scale 1"=400ft.

Application No.G-14211 Permit No. G-12927

Application No.R-80675 Permit No. R-11829

in the name of

Mark Elder

Surveyed 11/14/98 by Walter L Trimmer, CWRE 332