


TOWNSHIP 11 SOUTH



Received by OWRD
JUN 14 2024
Salem, OR

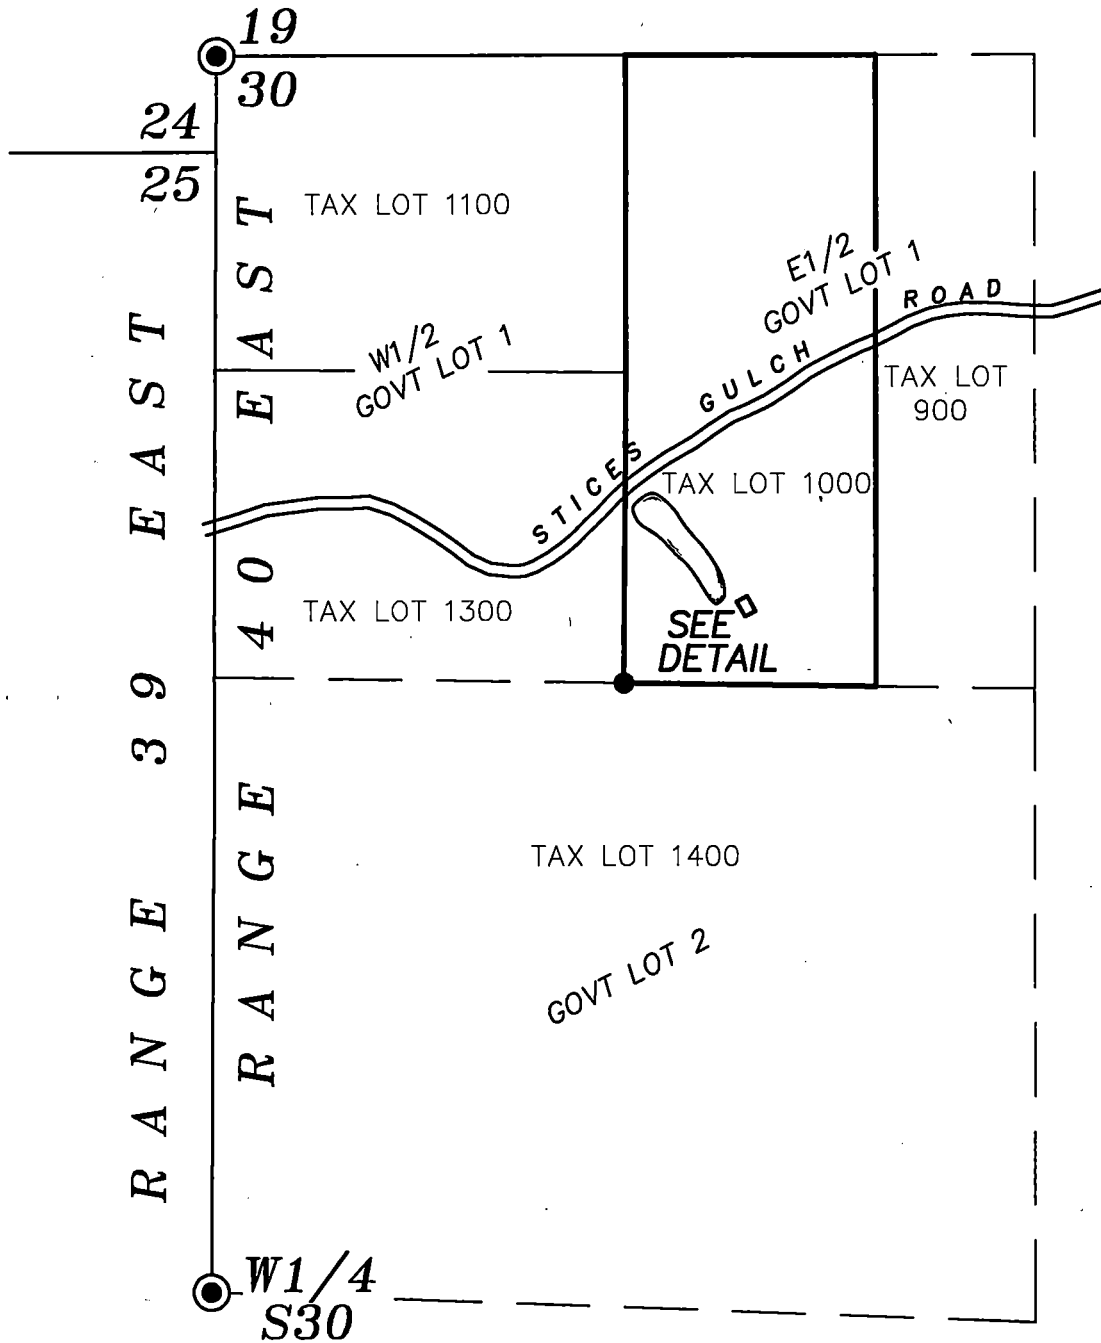

OVERALL VIEW

May 8, 2024

CLAIM OF BENEFICIAL USE
FOR A STORAGE RIGHT

FOR
CRAIG AND JILL BLACKBURN

APPLICATION NO.

R-74536

PERMIT NUMBER

R-12194

SCALE: 1"=400'


DETAIL VIEW

May 8, 2024

CLAIM OF BENEFICIAL USE
FOR A STORAGE RIGHT

FOR
CRAIG AND JILL BLACKBURN

Situated in the Northwest quarter of
Section 30, Township 11 South, Range
40 East of the Willamette Meridian,
Baker County, Oregon

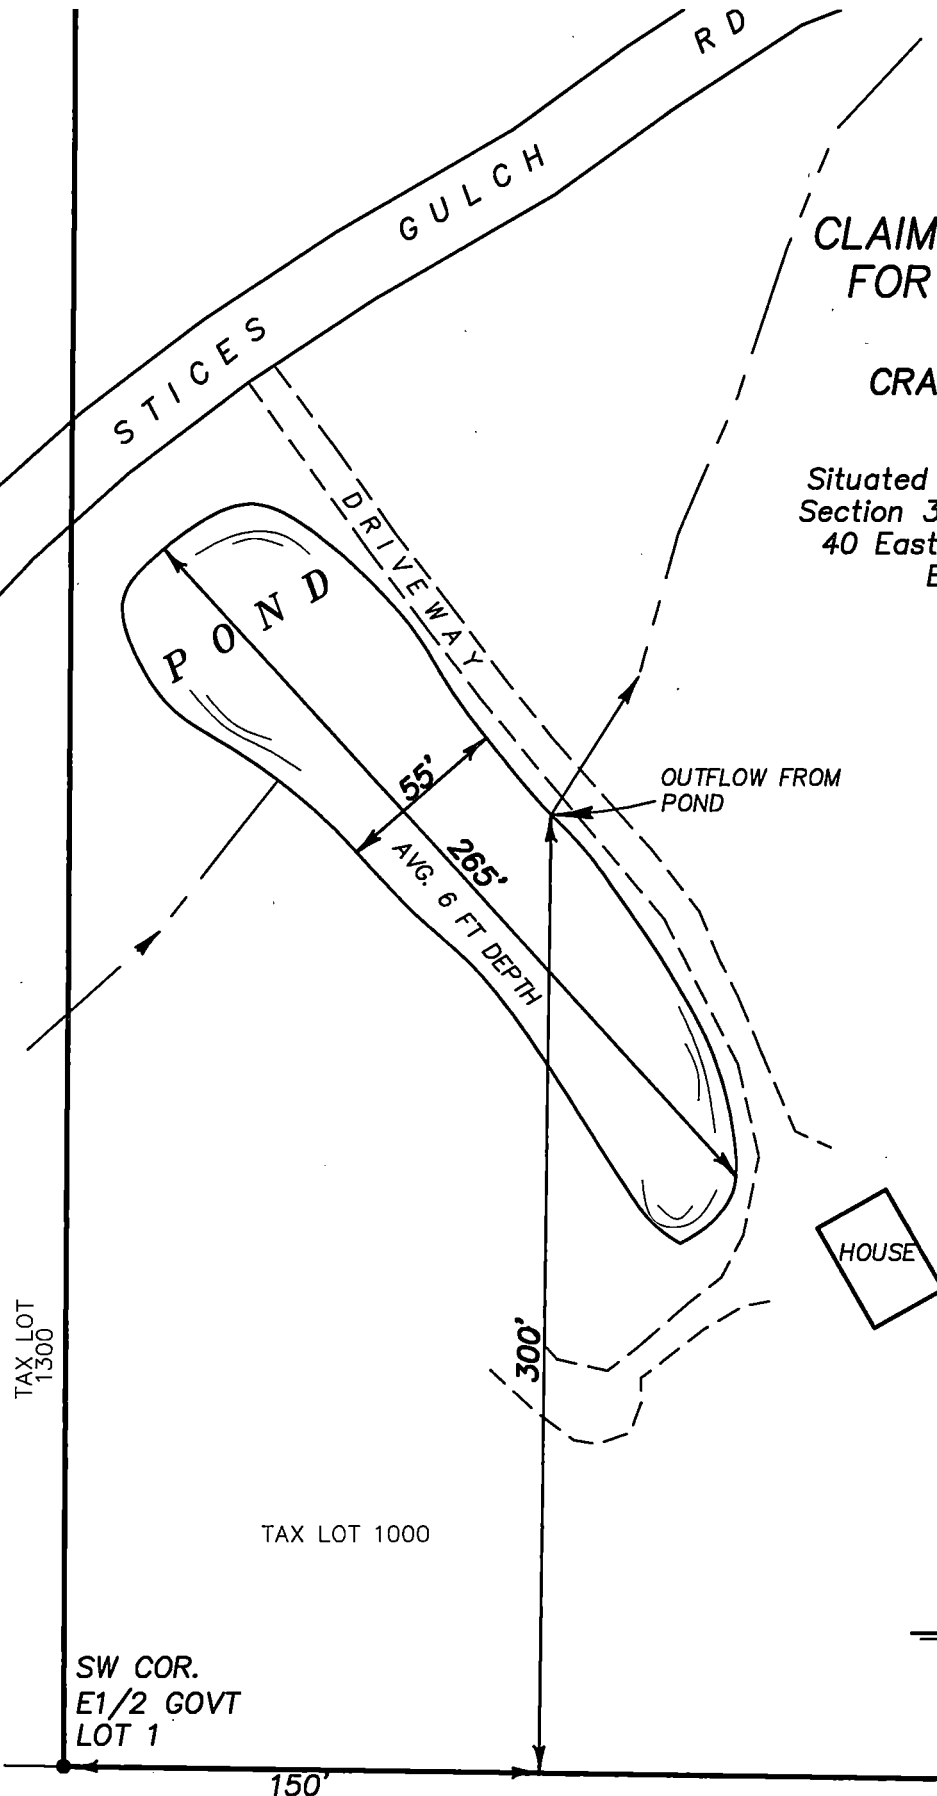

SCALE: 1"=60'

Received by OW/RD

JUN 14 2024

Salem, OR

APPLICATION NO.

R-74536

PERMIT NUMBER

R-12194