


Limited Water Use License Application Map for Waite Ranch Tidal Wetland Restoration Project

Point of Diversion: 371' South and 10' West from NE Corner of Township 18 S, Range 11 W, Section 20

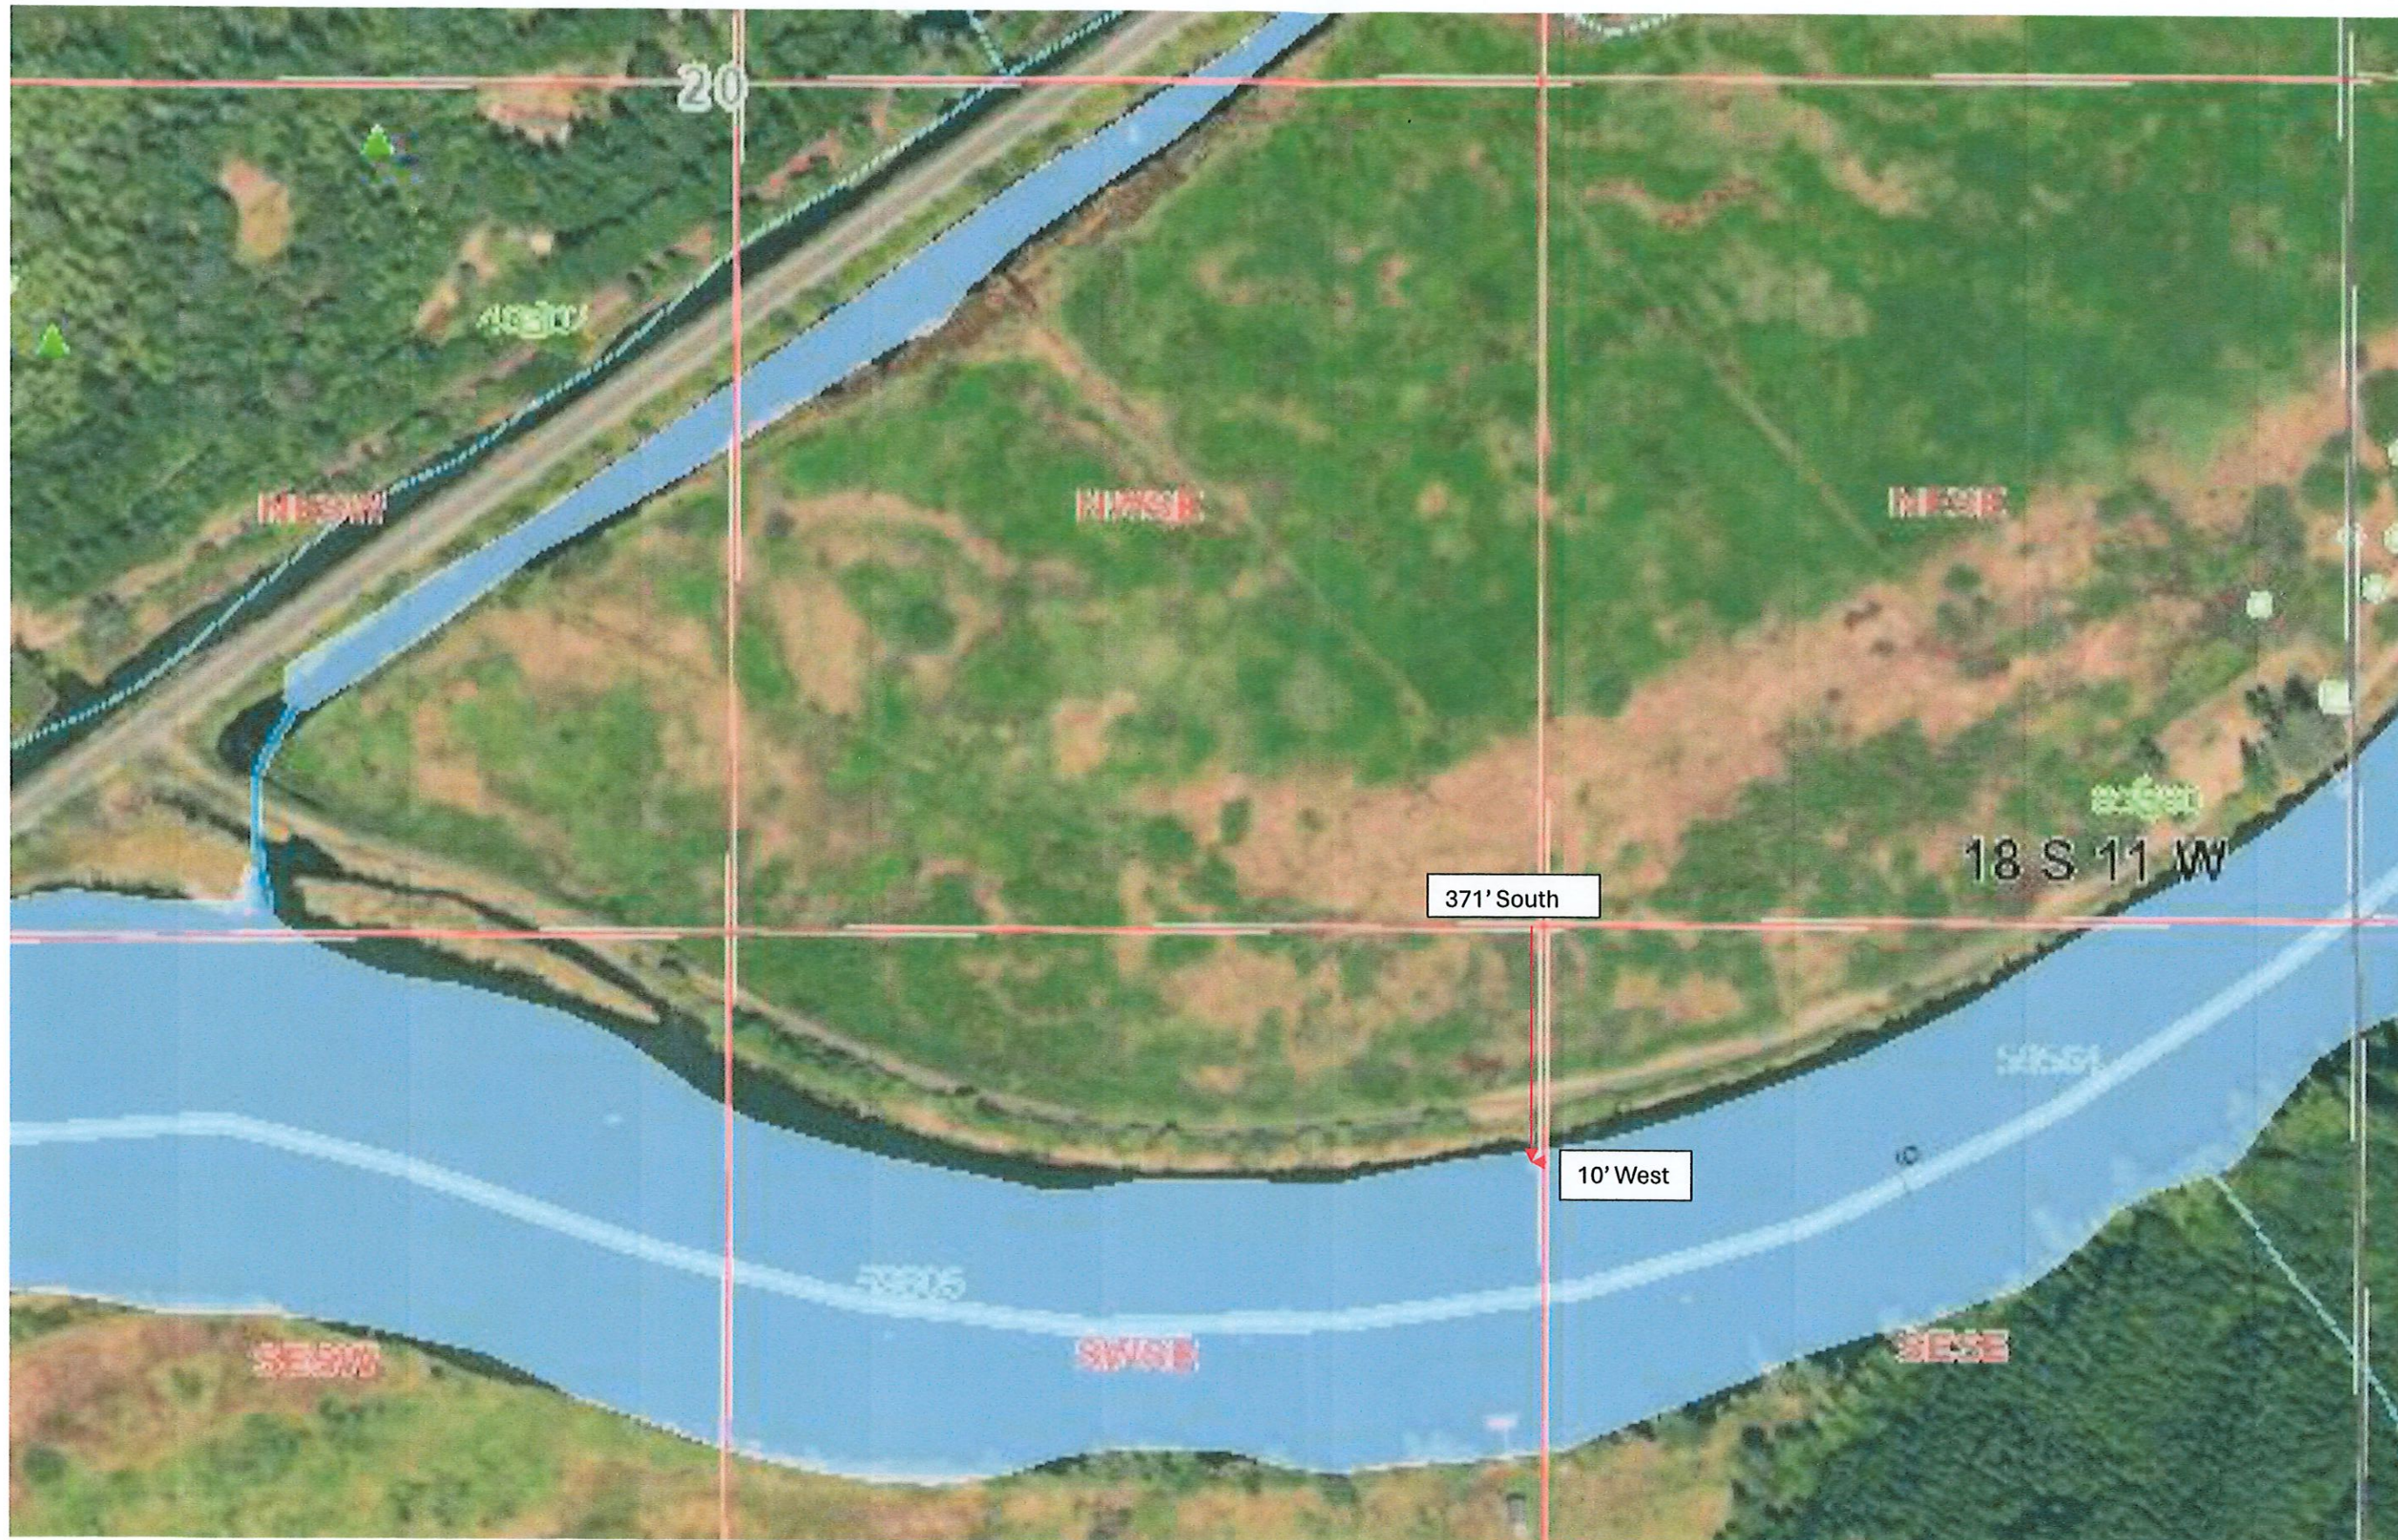

Received by CWRD
JUN 12 2024
Salem, OR

