

SEC. 8, T.6S, R.2E, W.M.


RECEIVED

FEB 24 1998

WATER RESOURCES DEPT.
SALEM, OREGON

N

SCALE
1"=400'

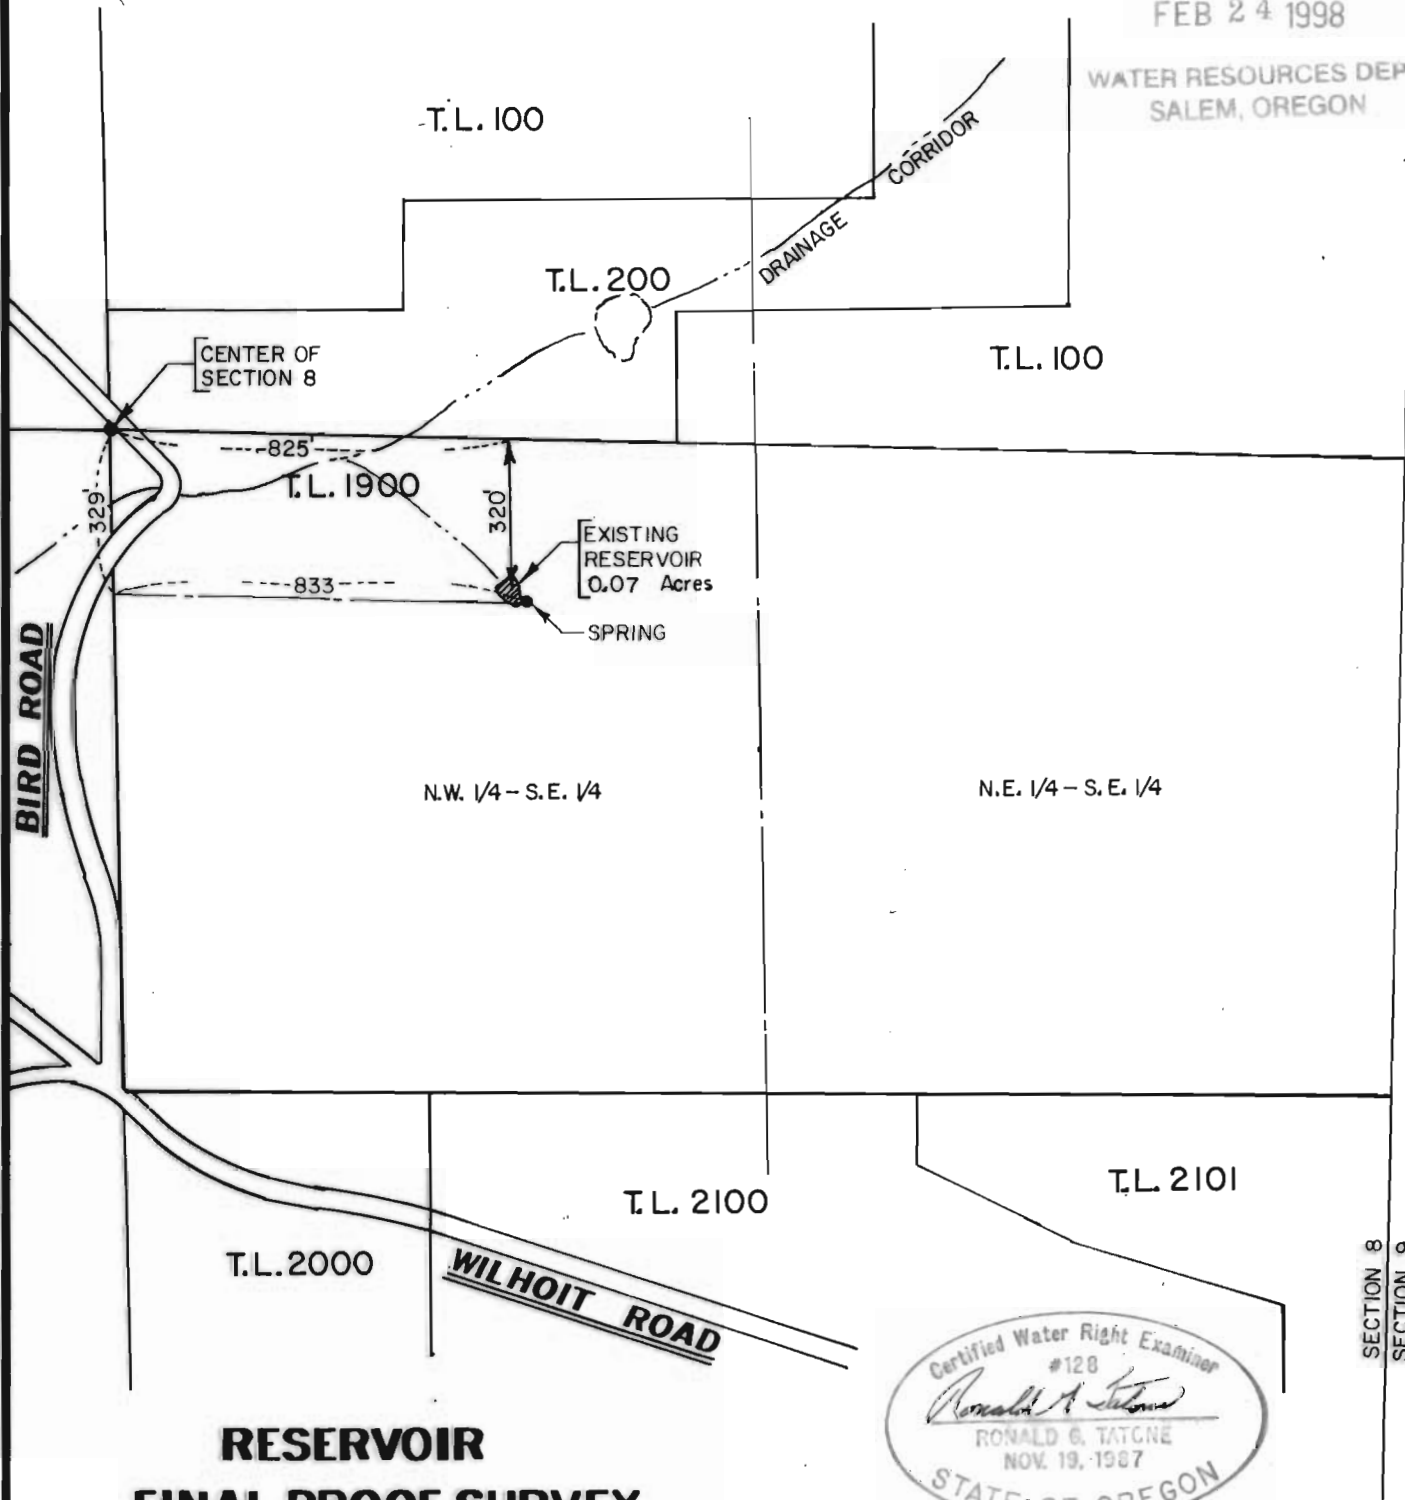

**RESERVOIR
FINAL PROOF SURVEY
FOR
MILDRED HICKS**
APPLICATION NO. R-72388
PERMIT NO. R-11485



ZTec ENGINEERS, INC.

3737 S.E. 8TH AVE., PORTLAND, OR. 97202
PHONE: (503) 235-8795
FAX: (503) 233-7889