

1" = 1320'

NOTE: THIS MAP IS PREPARED FOR WATER RIGHT PURPOSES ONLY AND SHOULD NOT BE USED FOR PROPERTY LOCATION PURPOSES.

RECEIVED



DEC 29 1997

WATER RESOURCES DEPT.
SALEM, OREGON

POD. FOR POND NO. 1 IS 1550' S, 100' W OF NE CORNER OF SEC 16 T2S R44E. POND NO. 1 IS WITHIN THE SE 1/4, NE 1/4 SEC 16.

POD. FOR POND NO. 2 IS 1500' S, 50' E OF NW CORNER OF SEC 15, T2S R44E. POND NO. 2 IS WITHIN THE SW 1/4, NE 1/4, SEC 15.

UNNAMED STREAMS FEEDING PONDS ARE TRIBUTARIES OF THE WALLOWA RIVER, IN THE GRANDE RONDE BASIN.

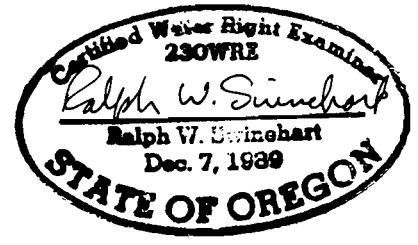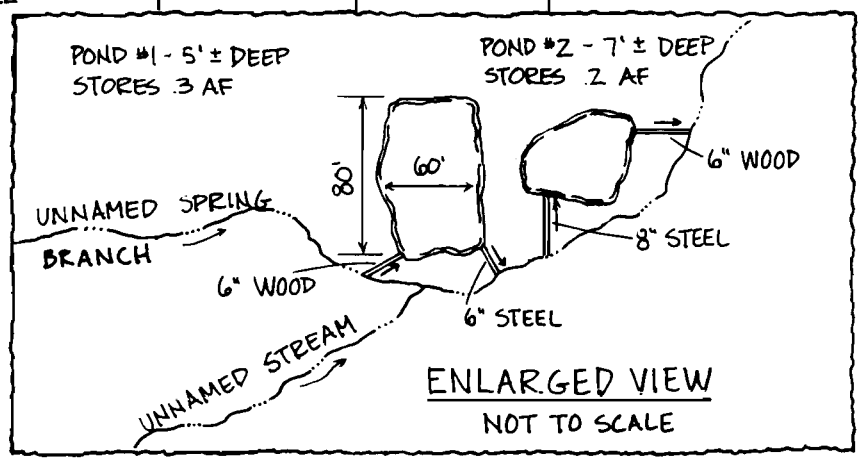

FINAL PROOF MAP RESERVOIR PERMIT R-12124 IN SECTIONS 15 & 16, T2S, R44E, WM WALLOWA COUNTY FOR: GREG JOHNSON	DATE	12/97	WALLOWA MOUNTAIN ENGINEERING PO Box 266 ENTERPRISE, OREGON 97828 426-4085	REVISIONS
	JOB	97837		SHEET
	DESIGN	RWS		1 OF
	DRAWN	TCB		1