


T. 9 S. R. 1 W. W.M.

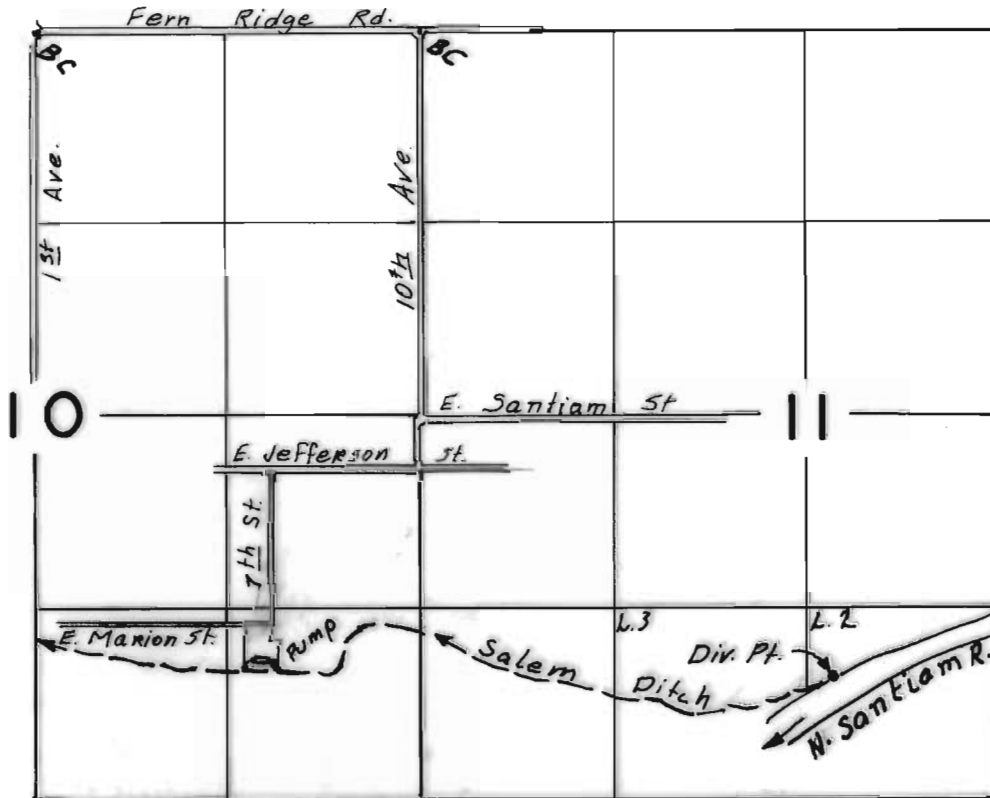

Div. Pt. loc. 1800' S & 2830' E from W 1/4 COR. Sec. 11
 Ditch Pump loc. 1750' S & 990' W " " " "

RECEIVED


SEP 14 1999

WATER RESOURCES DEPT.
 SALEM, OREGON

FINAL PROOF SURVEY UNDER

Application No. R-72409 Permit No. R-11557
 IN NAME OF

DAVID & BEVERLY THOMPSON

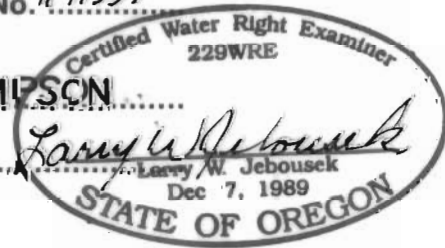

Surveyed Feb. 14, 1992, by
 Aug. 13, 1999

THIS MAP WAS PREPARED FOR THE PURPOSE OF IDENTIFYING THE LOCATION OF A WATER RIGHT ONLY AND IS NOT INTENDED TO PROVIDE LEGAL DIMENSIONS OR LOCATION OF PROPERTY OWNERSHIP LINES.

Marion Co. Survey 1992 WAC Photo