


FINAL PROOF SURVEY MAP IN THE NAME OF LAUREL CREEK ACRES, LLC

APPLICATION R-72438
S-72439

PERMIT R-11755
S-52121

SECTION 31, TOWNSHIP 29 SOUTH, RANGE 14 WEST, W.M.

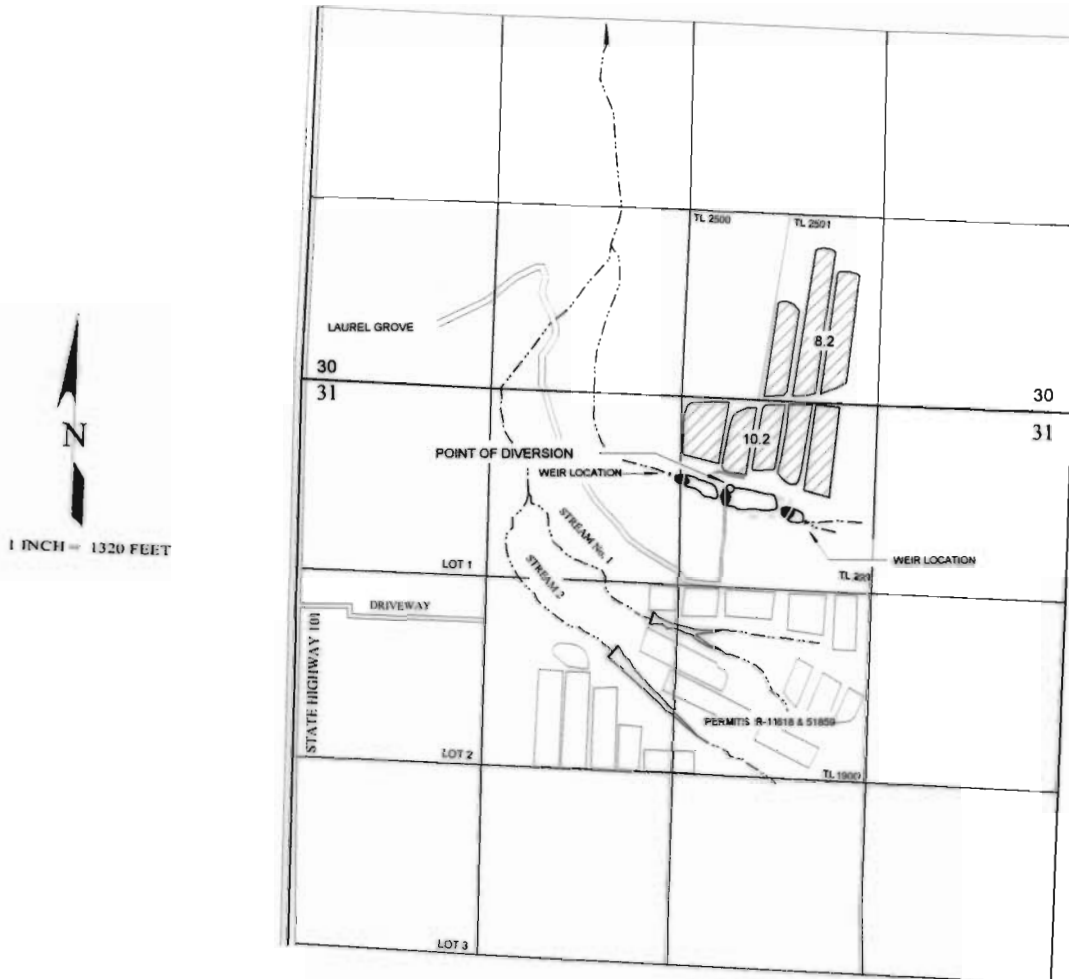

THE POINT OF DIVERSION IS LOCATED 325 FEET EAST AND 640 FEET SOUTH FROM THE NORTH QUARTER CORNER OF SECTION 31; BEING WITHIN THE NW¼ NE¼ OF SECTION 31, TOWNSHIP 29 SOUTH, RANGE 14 WEST, W.M.; COOS COUNTY.

THE DAMS ARE LOCATED AS FOLLOWS:

- NO. 1: 570 FEET SOUTH AND 5 FEET EAST;
NO. 2: 675 FEET SOUTH AND 295 FEET EAST; AND
NO. 3: 800 FEET SOUTH AND 720 FEET EAST; ALL FROM THE NORTH QUARTER CORNER OF SECTION 31; BEING WITHIN THE NW¼ NE¼ OF SECTION 31, TOWNSHIP 29 SOUTH, RANGE 14 WEST, W.M.; COOS COUNTY.



RECEIVED

SEP 16 2004

WATER RESOURCES DEPT
SALEM, OREGON