


Township 38S, Range 4W

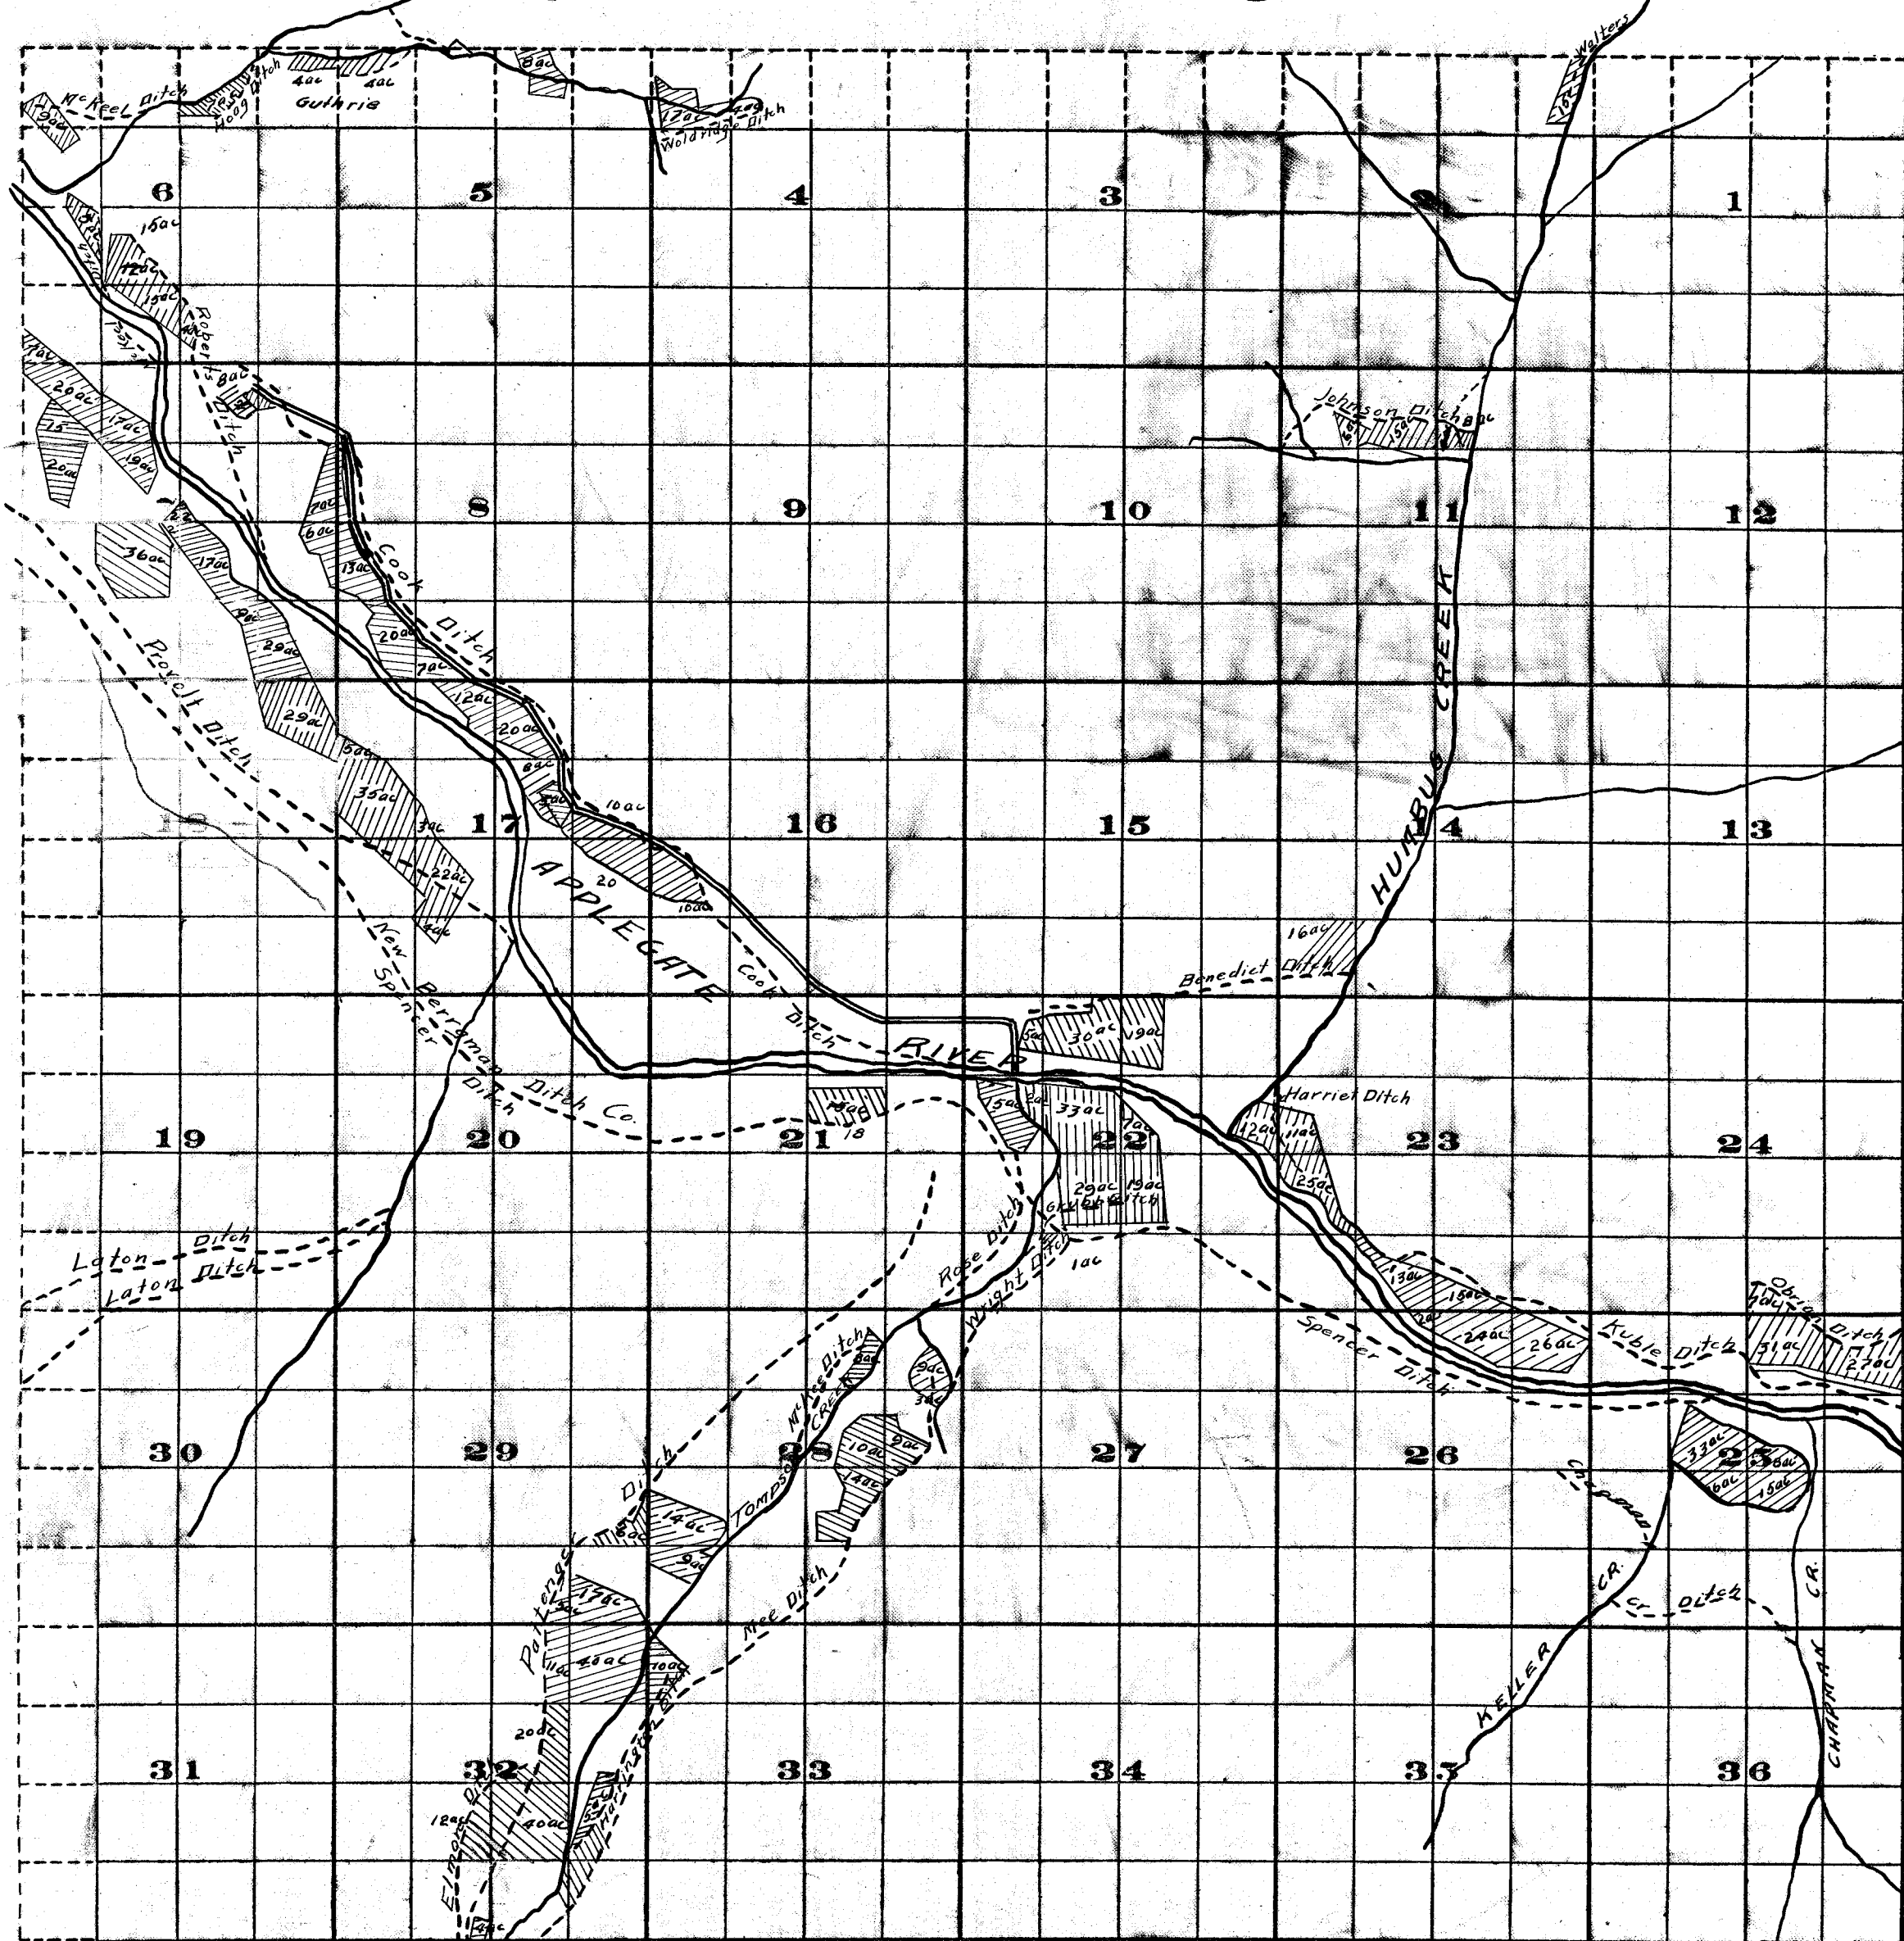

Survey by McMahon April 1810
 Scale of Feet.

FROM OFFICE OF THE STATE ENGINEER, SALEM, OREGON

M.D.
 D.F.M. 11/7/11

Adjudication
 Rogue River and Tributaries
 John H. Lewis State Engr

Examined Sept. 18, 1911