


THIS MAP WAS PREPARED FOR ASSESSMENT PURPOSE ONLY

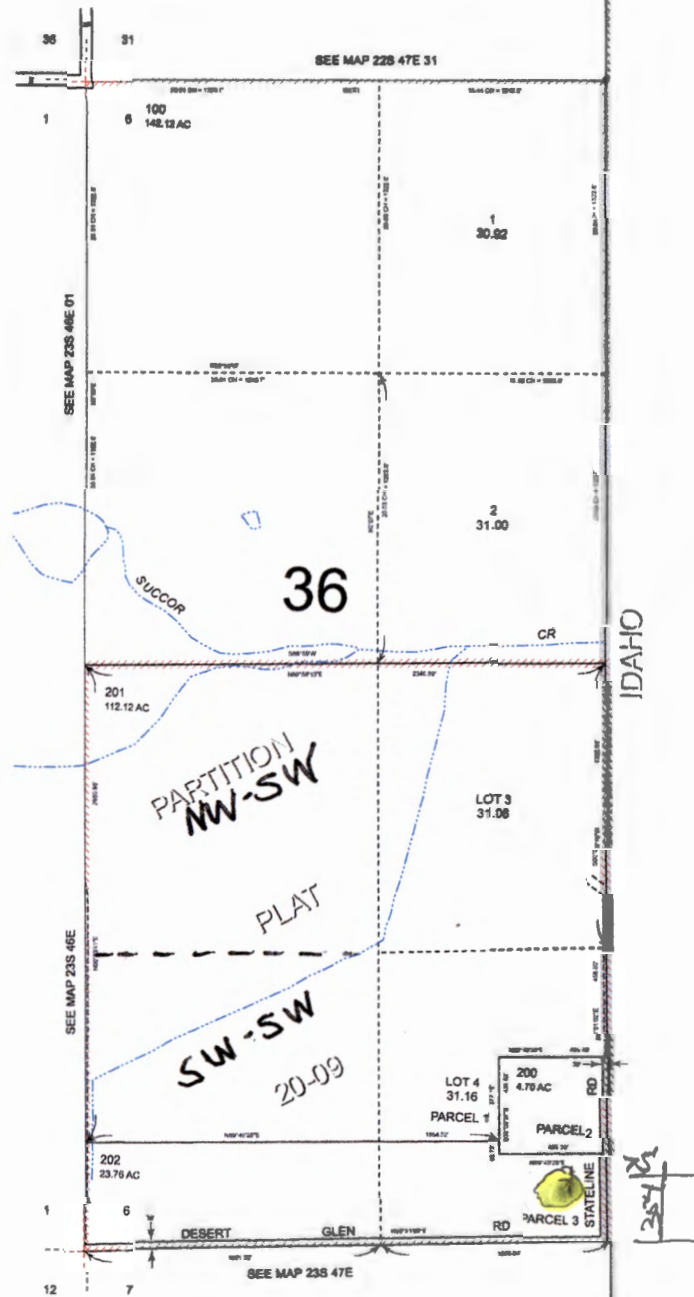

SECTION 6 T.23S. R.47E. W.M.
MALHEUR COUNTY
1" = 400'

23S47E06



Received
JUN 24 2024
OWRD

Smihw A. #2
Center of Dam
N. 354 Ft SW corner/corn
West 75 Ft SW corner/corn

Revised: MA
05/28/2020

23S47E06